


THIS DRAWING IS THE COPYRIGHT OF HUNTS OFFICE AND SHOULD NOT BE USED, COPIED OR ALTERED BY A THIRD PARTY WITHOUT PRIOR WRITTEN CONSENT.

HUNTS OFFICE WILL NOT ACCEPT RESPONSIBILITY FOR THE ACCURACY OF PLANS SUPPLIED BY A THIRD PARTY.

THIS DRAWING IS SUBJECT TO CHANGE DUE TO POTENTIAL THIRD PARTY CONSTRUCTION WORK. ONCE THE STRUCTURAL ALTERATIONS HAVE BEEN MADE, AN ADDITIONAL SURVEY WILL BE REQUIRED.

PLEASE NOTE THAT THIS DRAWING HAS ORIGINATED FROM A THIRD PARTY SURVEY OR DRAWING.

 = MOVED FURNITURE

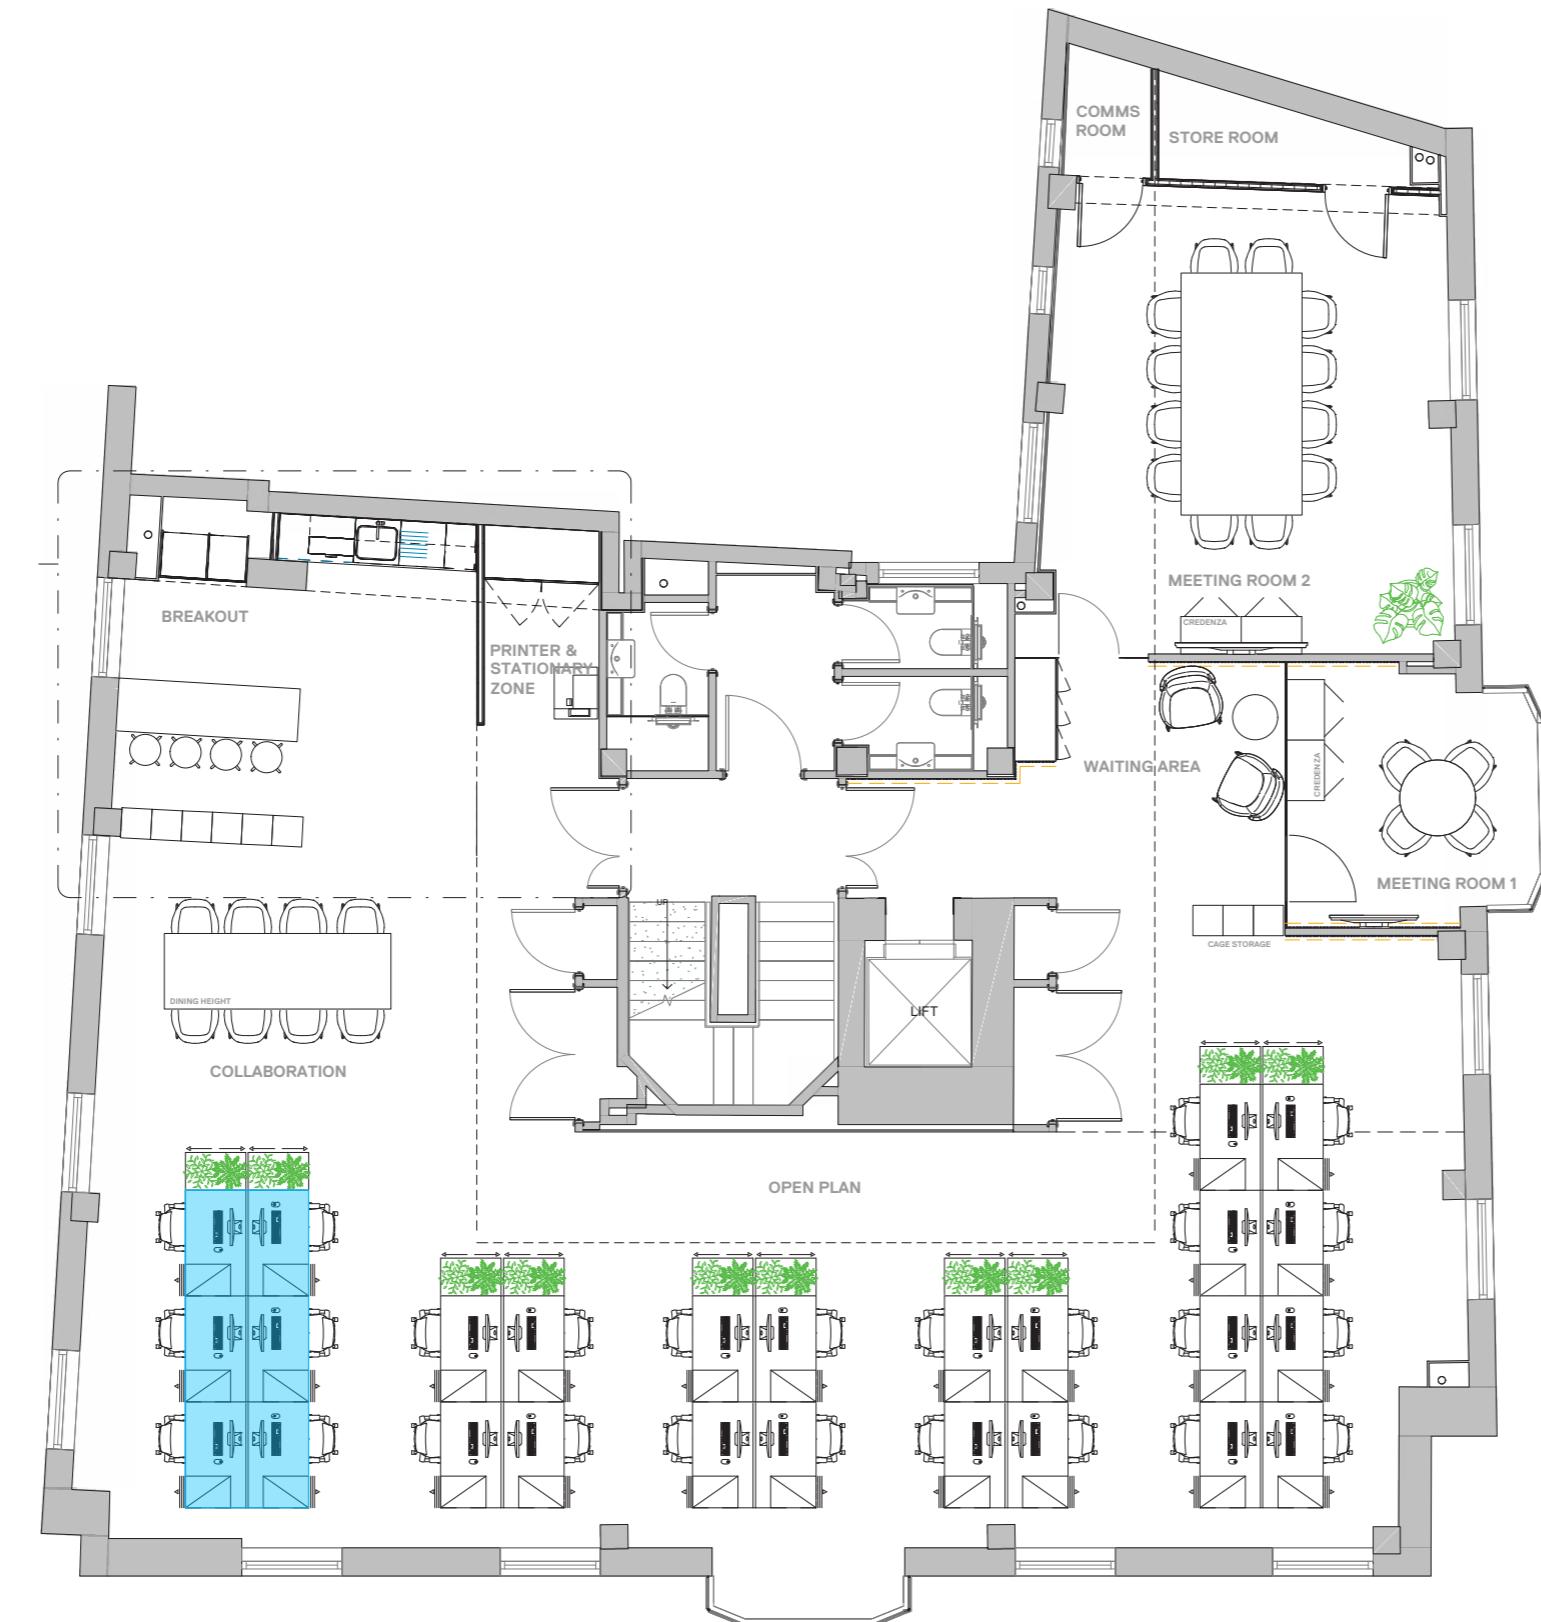

B	23.09.25	HP	CLIENT COMMENTS 22.09.25
A	22.09.25	HP	CLIENT COMMENTS 18.09.25
REV:	DATE:	BY:	DESCRIPTION:

PROPOSAL



01992 256424 WEST END RD | HIGH WYCOMBE | HP11 2QG HUNTOFFICE.CO.UK

CLIENT: PEMBREY ASSET MANAGEMENT

PROJECT DETAILS:

35 KING STREET, LONDON EC2V 8EH

DWG No: PDR-2001-HUNTS-01-3F-100 REV: B

AM:	L.MEZIANI	DB:	H.PUTTICK	SCALE:	A3 @ 1:100
-----	-----------	-----	-----------	--------	------------

THIRD FLOOR GA