


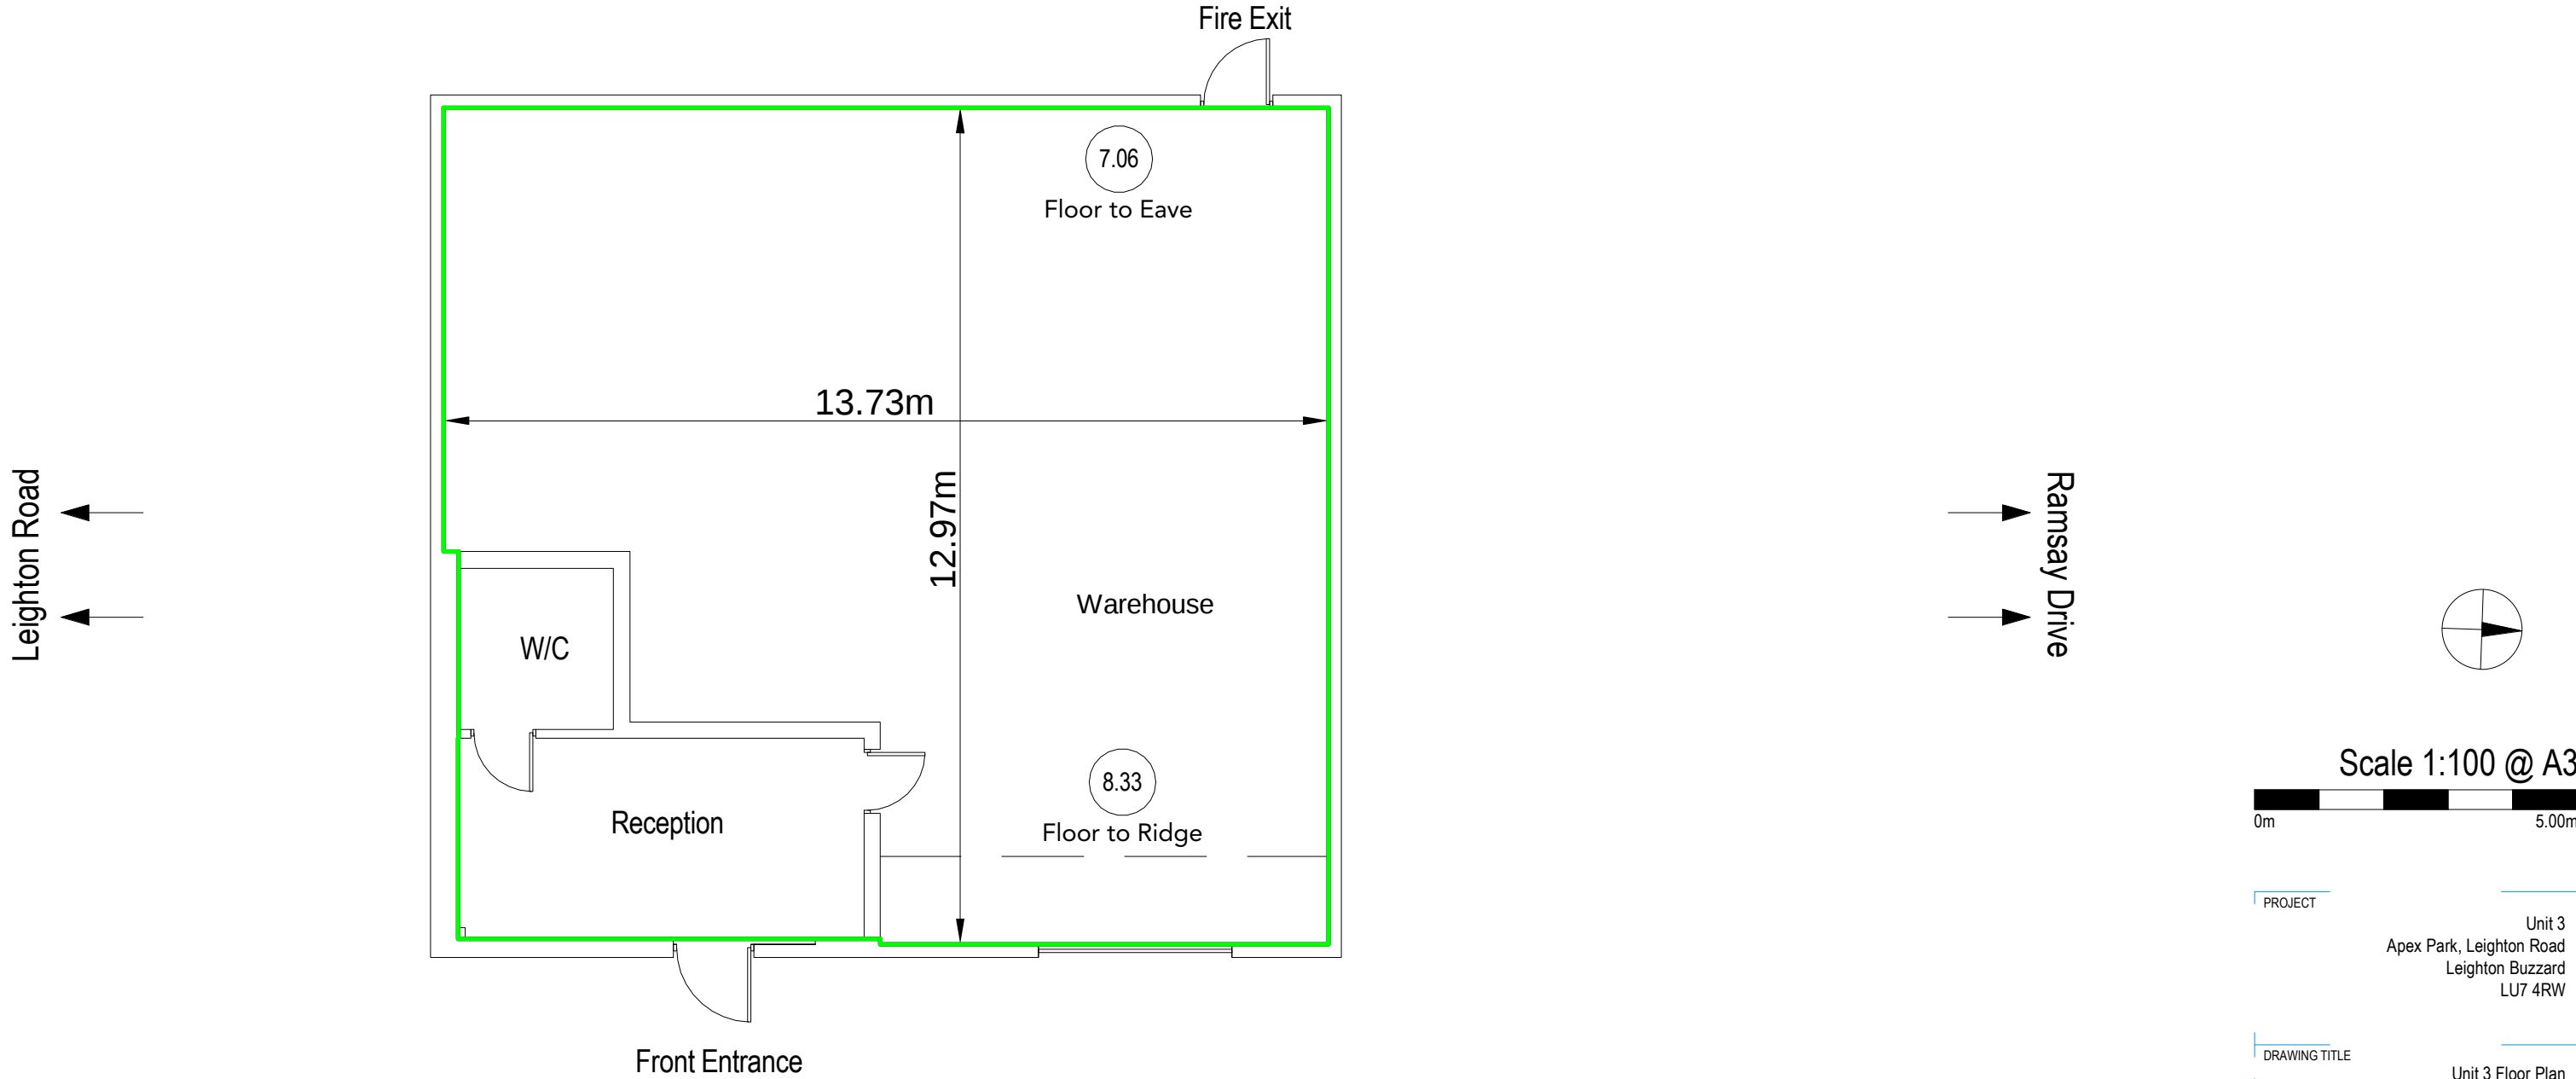

PROJECT

Unit 3
Apex Park, Leighton Road
Leighton Buzzard
LU7 4RW

DRAWING TITLE

Unit 3 Floor Plan

SCALE

1 : 100 @ A3

Area Measurement Report

DRAWN BY

DATE OF INSPECTION

RB_

02/02/2022

QA ASSESSOR

DRAWING NO.

JA

10117085_ A5



CONTACT

E: surveys@presurveyors.co.uk

London: +44 (0) 20 7233 6668

Croydon: +44 (0) 20 8406 3000

Bristol: +44 (0) 1172 39 9303

W: www.presurveyors.co.uk

- DO NOT SCALE FROM THIS DRAWING. USE FIGURED DIMENSIONS ONLY.
- ALL DIMENSION ARE IN MILLIMETRES UNLESS STATED OTHERWISE.
- THE CONTRACTOR IS TO CHECK DRAWINGS AND TO VERIFY ALL DIMNESIONS ON SITE BEFORE COMMENCING ANY WORK OR MAKING ANY SHOP DRAWINGS.
- THIS DRAWING IS THE PROPERTY OF PRE SURVEYORS LIMITED. COPYRIGHT IS RESERVED BY THEM AND THE DRAWING IS ISSUED ON THE CONDITION THAT IT IS NOT COPIED, REPRODUCED, RETAINED OR DISCLOSED TO ANY UNAUTHORISED PERSON, EITHER WHOLLY OR IN PART, WITHOUT THE CONSENT IN WRITING OF PRE SURVEYORS LIMITED.
- ALL STRUCTURAL ELEMENTS ARE ASSUMED AND ARE SUBJECT TO REVIEW BY QUALIFIED STRUCTURAL ENGINEER.