

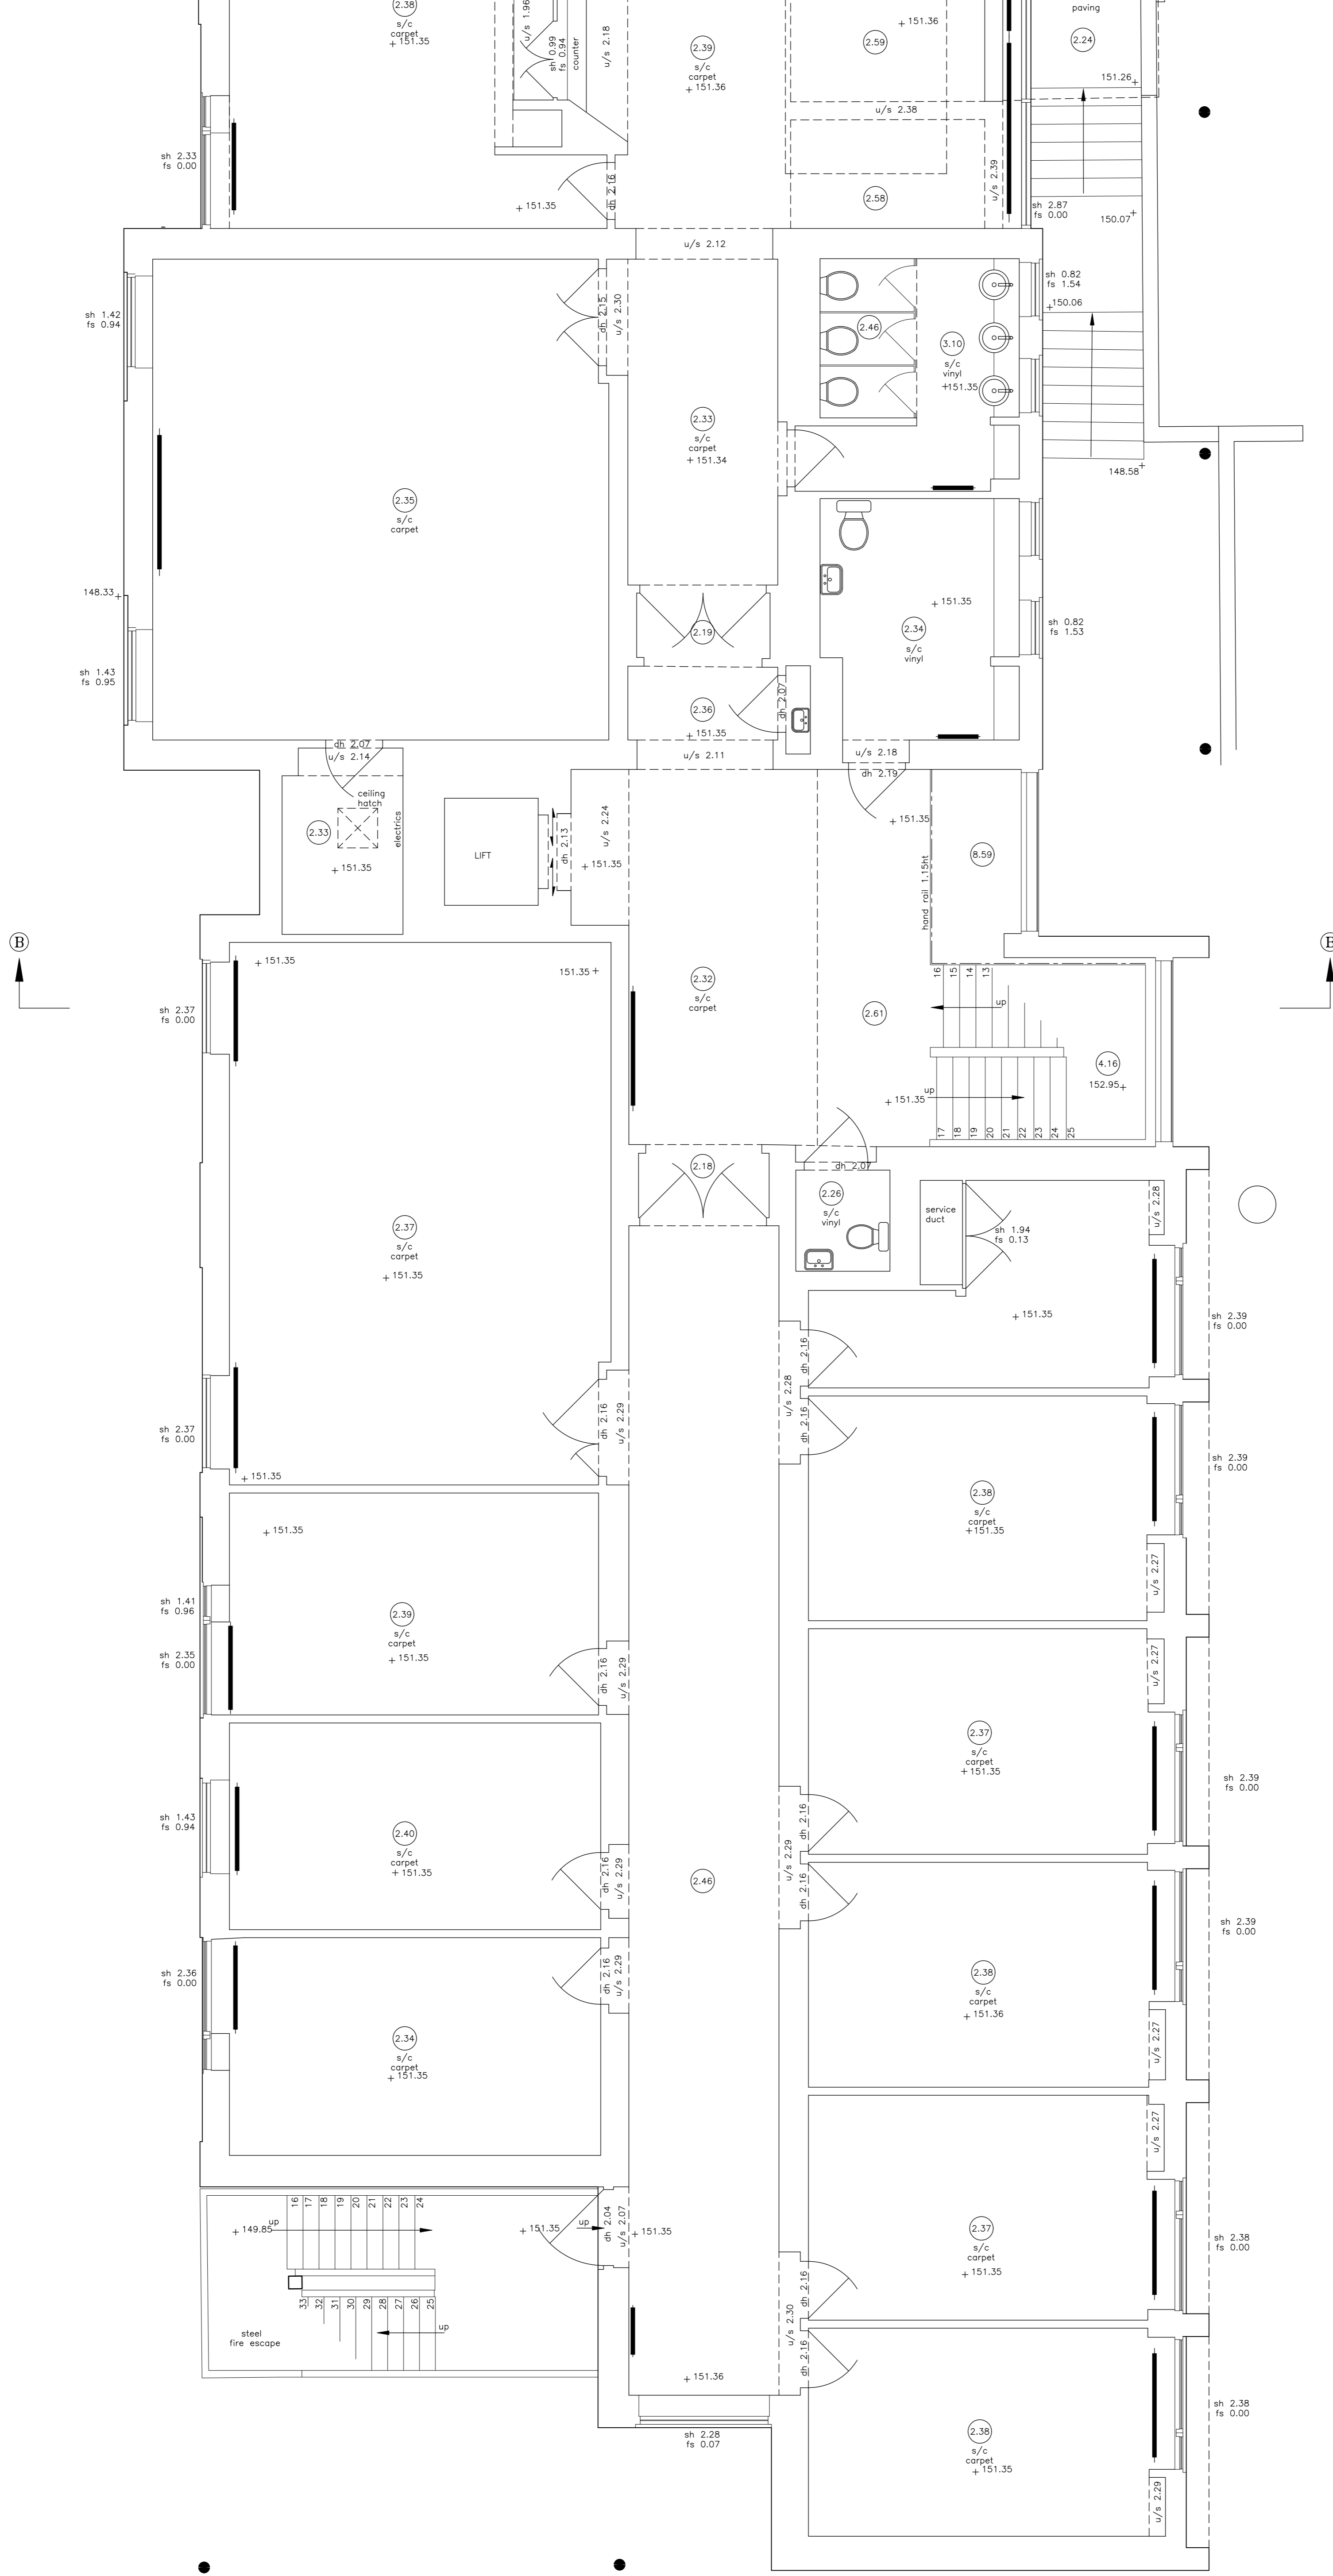


Notes

ALL LEVELS ARE IN METRES DERIVED FROM GPS TRANSFORMATION OSGM15  
 THE CO-ORDINATES ARE DERIVED FROM THE ORDNANCE SURVEY ACTIVE STATION NETWORK OSTN15 (BASE STATION ST02)

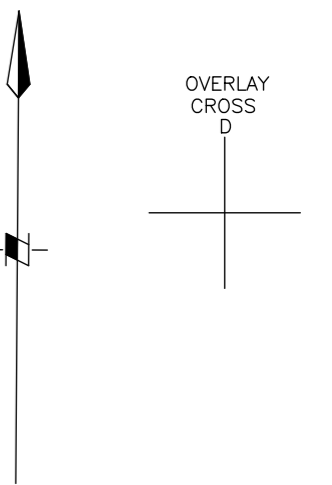

GROUND FLOOR

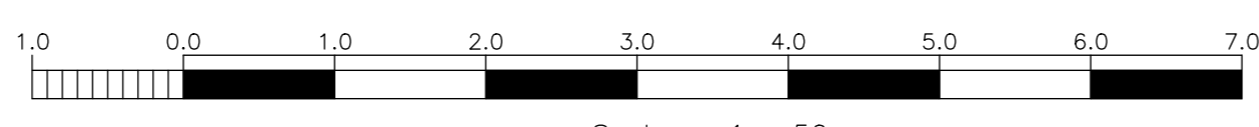

Scale = 1 : 50

AS/HL/RW © ON CENTRE SURVEYS LTD. 2026

job **BEVAN HOUSE & RAVENSBRURY HOUSE**  
**9 WESTBOURNE ROAD**  
**BIRMINGHAM**  
**WEST MIDLANDS**  
**B15 3TR**

client **CALTHORPE ESTATES**

title GROUND FLOOR BEVAN HOUSE	dwg no. 29785A/9/1
--------------------------------------	-----------------------

scale 1/50	date 9th March 2026
---------------	------------------------

**ON CENTRE SURVEYS LTD.**  
 LAND & BUILDING SURVEYORS  
 GEODETIC ENGINEERS  
 2 CHARLES COURT, BUDBROOKE ROAD, WARWICK CV34 5LZ  
 TEL: 01926 494294  
 E-MAIL: info@oncentre.co.uk  
 A member of The Survey Association

