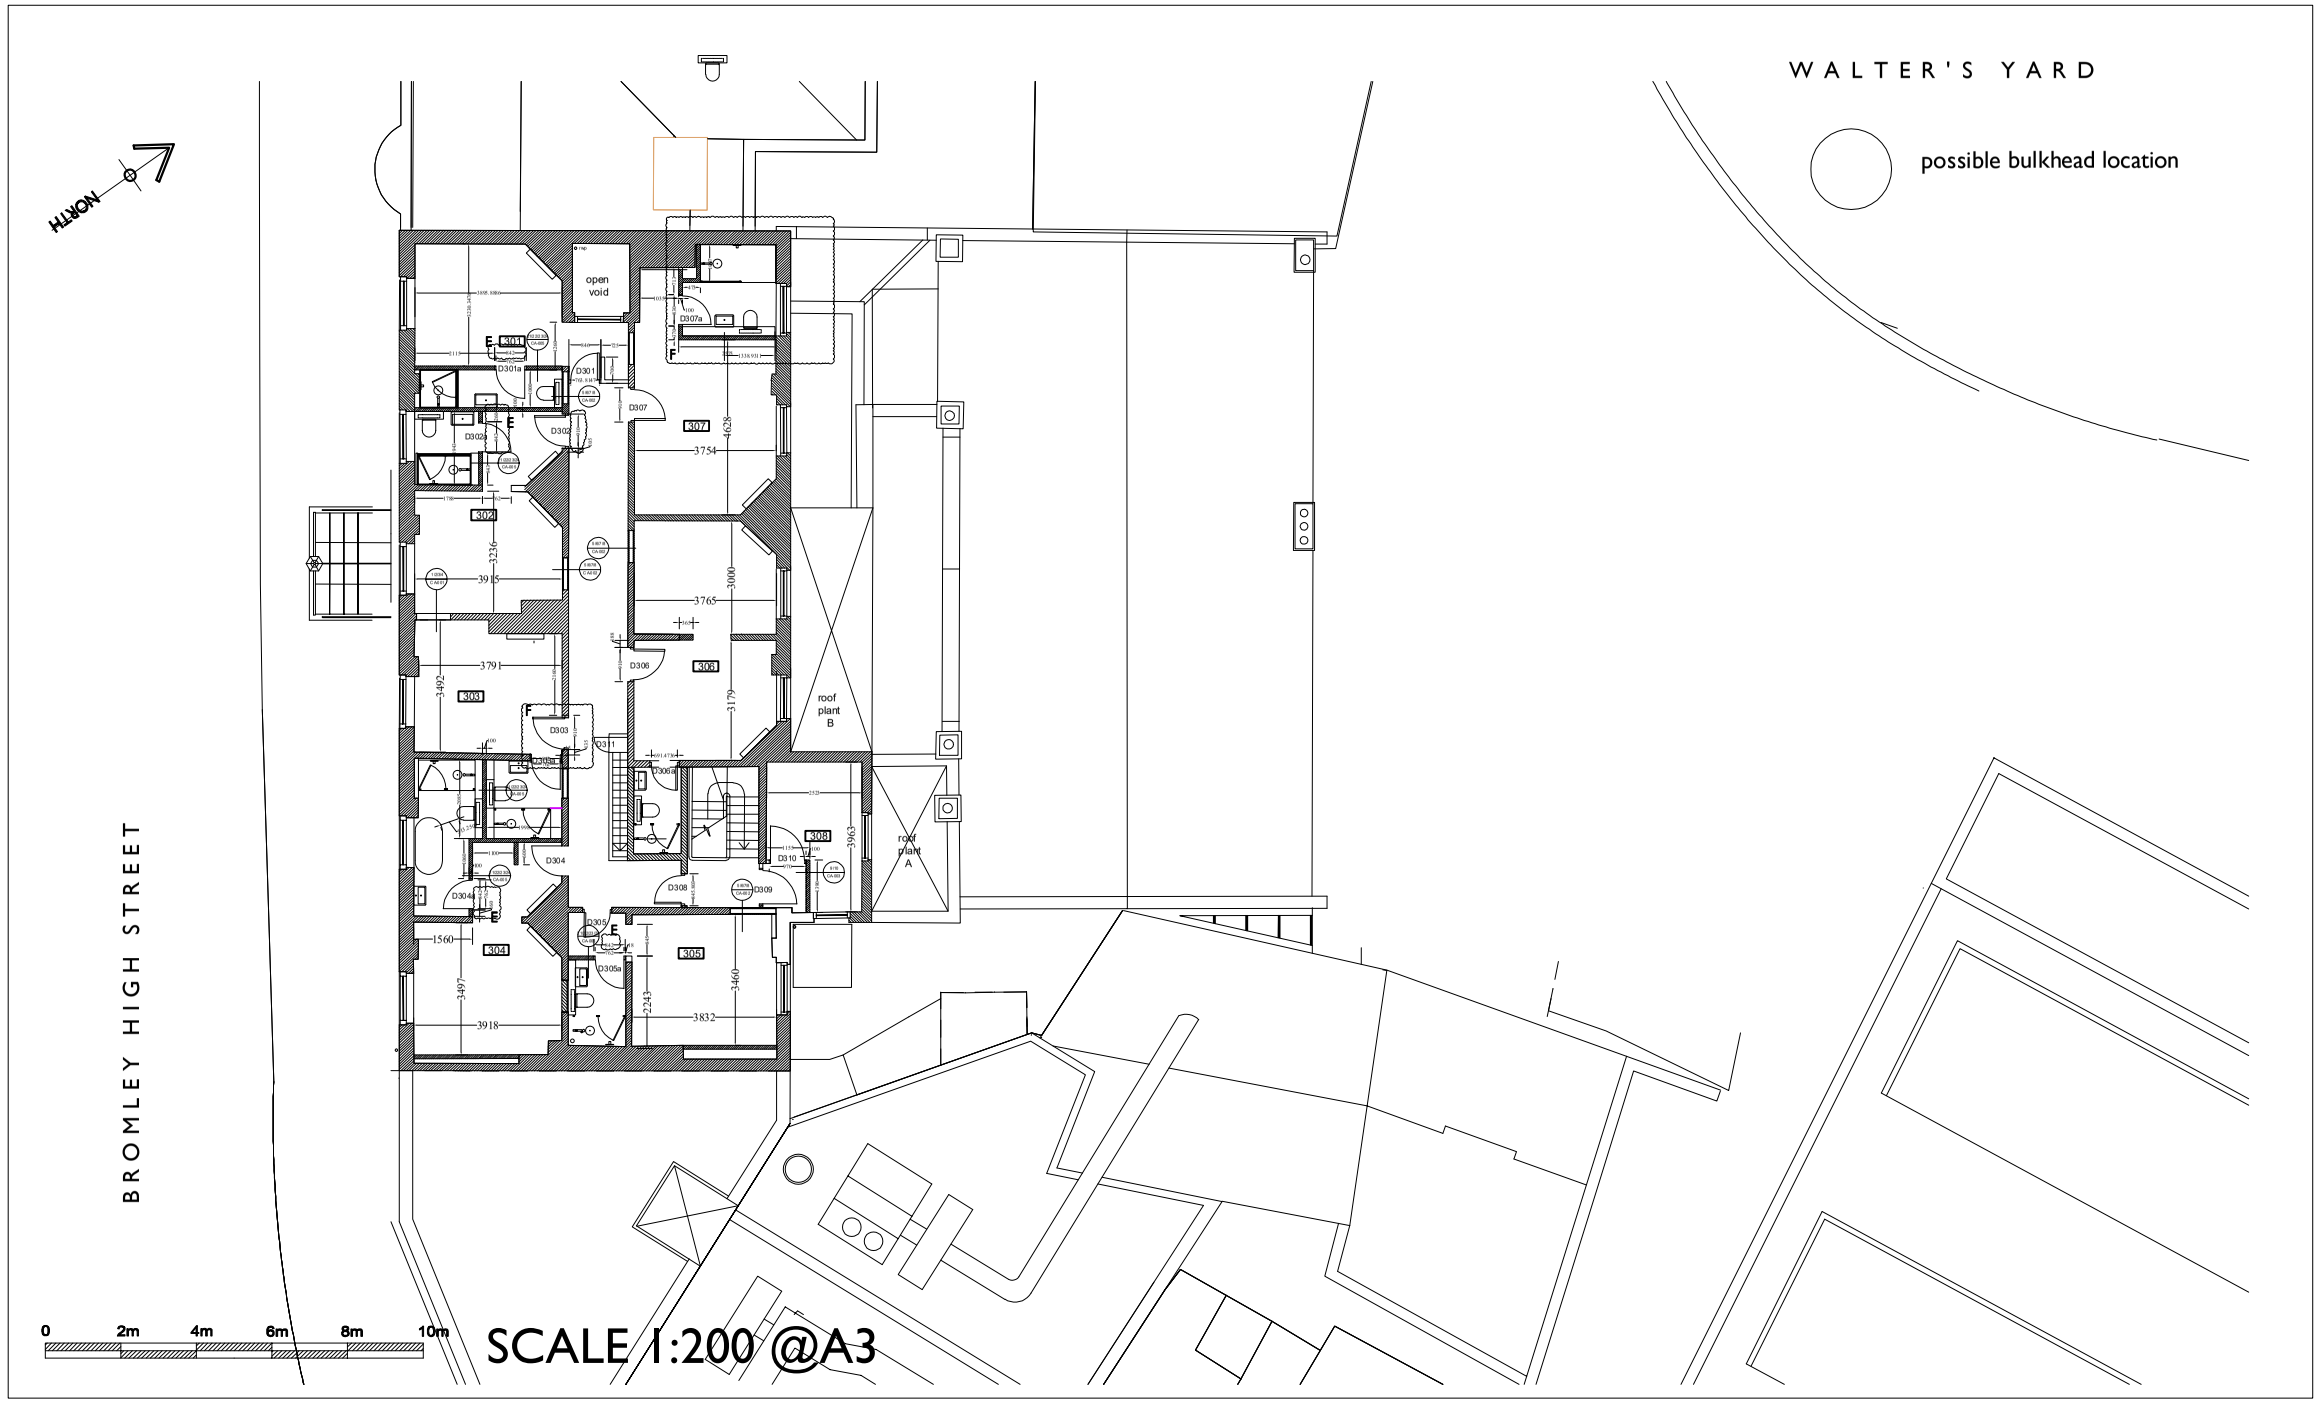

Notes
Do not scale from this drawing.
Contractor to take and check all dimensions on site before work commences. Discrepancies to be reported to the architect. Subcontractors to verify all dimensions on site before making shop drawings or commencing manufacture.

CAD File

Rev.	Description	Initial	Date
A	EXISTING ATTIC STAIR REINSTATED	MKE	19-11-24
B	DOOR NUMBERS ADDED	MKE	20-11-24
C	WALL DETAIL REFS ADDED	MKE	30-11-24
D	ADDITIONAL DIMS ADDED	MKE	24-03-25
E	BATHROOM DOOR SIZES REVISED	MKE	27-03-25
F	BATHROOM 307 RELOCATED DOOR 303 REVISED	MSE	04-04-25

Rev.	Description	Initial	Date

DENNER ELLIS BODDINGTON
CHARTERED ARCHITECTS
Phoenix Yard, 65 King's Cross Road, London WC1X 9LW
Telephone: 020 7239 4903 Fax: 020 78412 7482
E-Mail: architects@denelbod.co.uk

Client
TRB PROPERTY HOLDINGS LTD

ROYAL BELL
HIGH STREET
BROMLEY

Drawn | Checked | Status PLANNING

Title
PROPOSED THIRD FLOOR PLAN

Date | Plot Date XX-11-22
Scale 1:200@A3
Drawing no. 23/463 / GA-004 Revision F

