


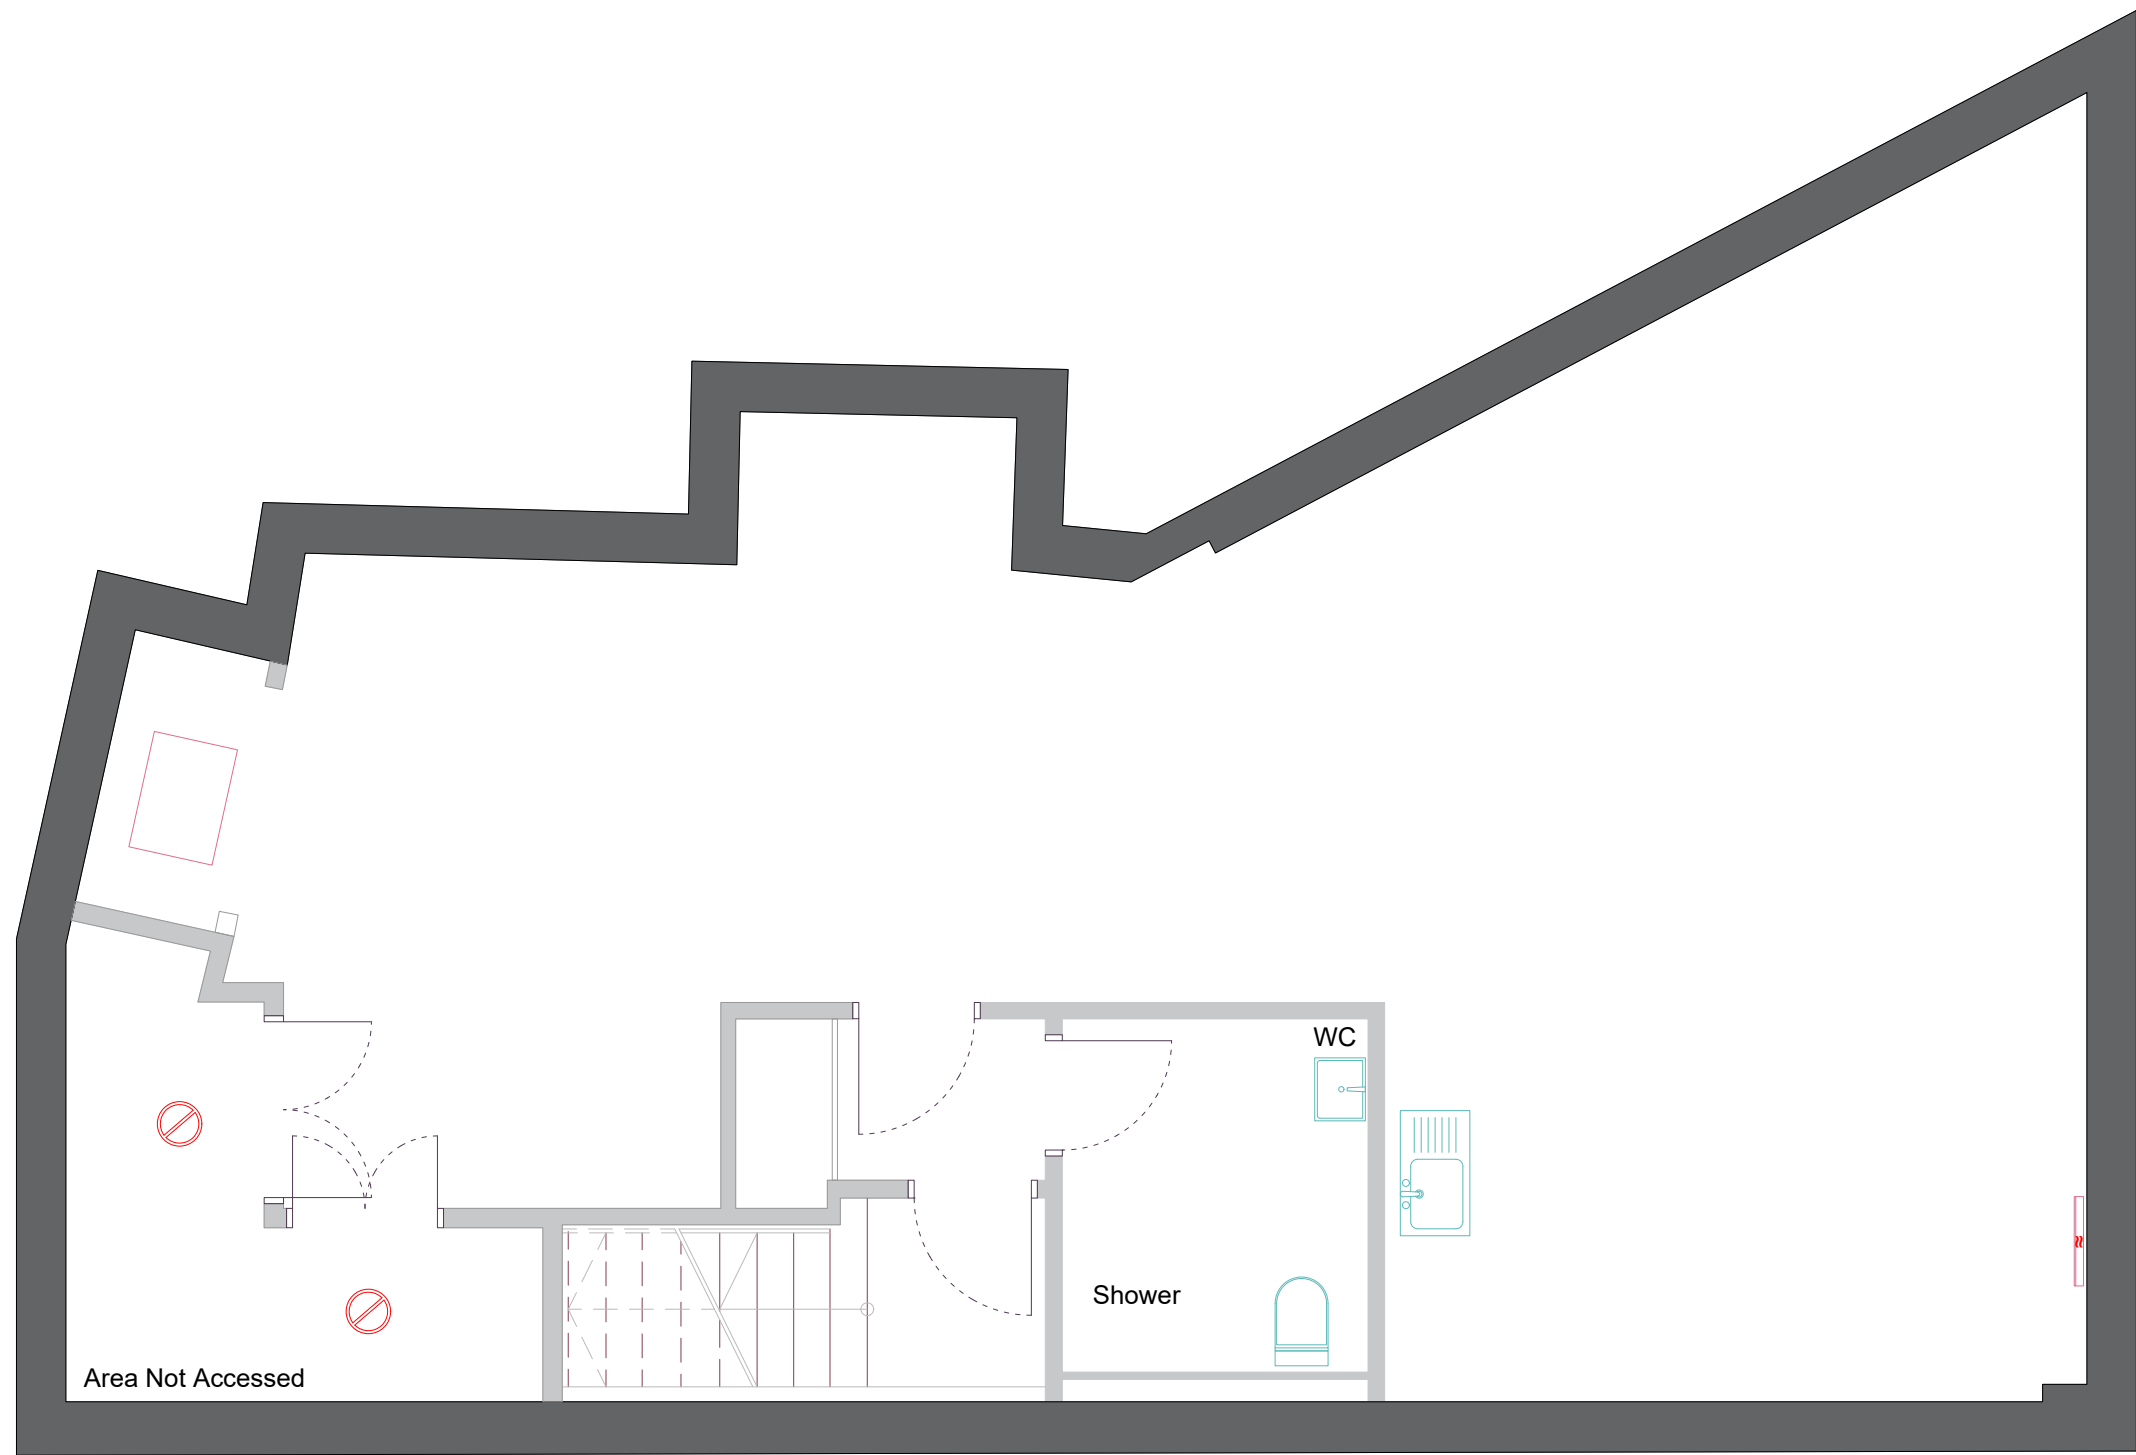

Lower Ground

Clerkenwell Close

42 Clerkenwell Close
London
EC1R 0AZ

Drawing Name
Lower Ground Floor Plan

REFERENCES

Date	Revision	Project Number	Description	Rev
15/07/2025	00	25.07.3360	Property Survey	0/0

0m 2.5m
Scale 1:50

sterlingtemple

0203 4639225
www.sterlingtemple.com