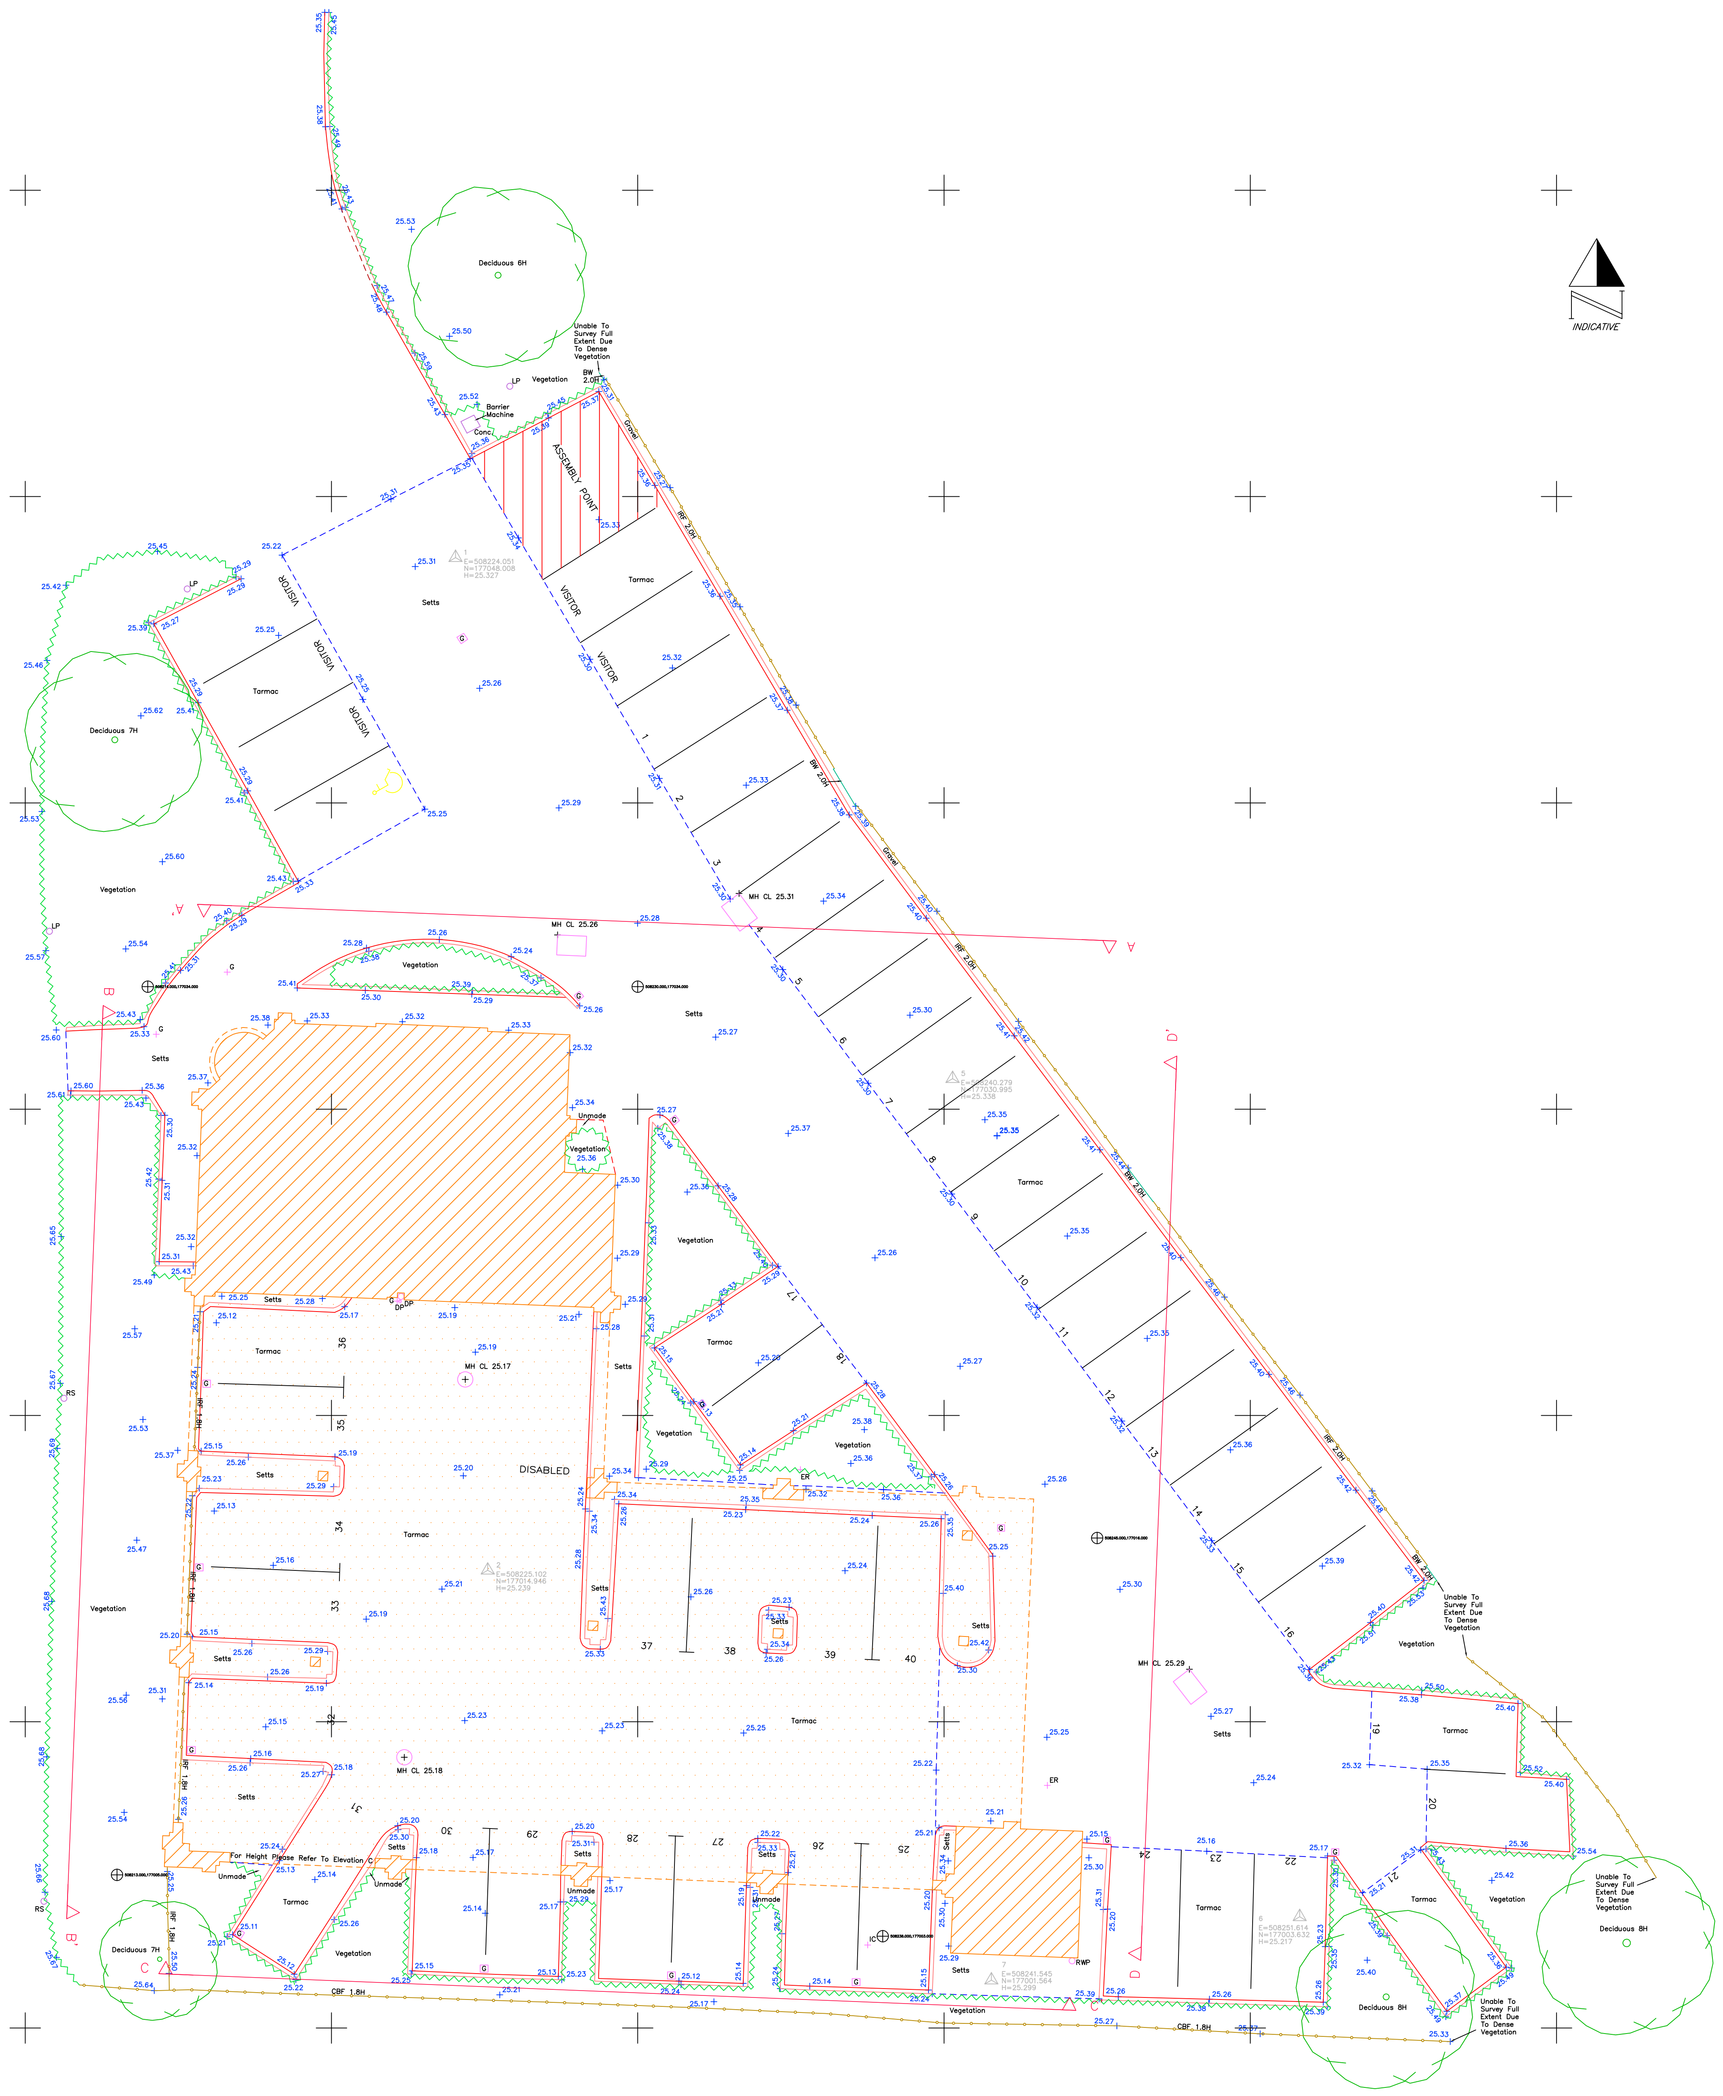

SURVEYED BY
PREMIER SURVEYS LIMITED
PREMIER SURVEYS LIMITED
FLOOR ONE UNIT 2
ELLESMERE BUSINESS PARK
HAYDN ROAD
NOTTINGHAM
NG5 1DX
Tel: 0115 9622876

OUR REF 6297

LEGEND

SURVEY STATION
BANK
CEILING HEIGHT
FLOOR BOARD DIRECTION
+ 12.34 LEVEL POSITION
REGISTRATION MARK
SAPLING
BUSH
BUILDING
BUILDING CANOPY

W — FRESH WATER
E — O/H ELECTRICITY
E — U/G ELECTRICITY
T — O/H TELEPHONE
T — U/G TELEPHONE
G — GAS
CTV — CABLE TELEVISION
FOUL DRAINAGE
STORM DRAINAGE
HEDGE
FENCE
GATE

ABBREVIATIONS (Where Applicable)

AC	AIR CONDITIONING UNIT	IC	INSPECTION COVER
AH	ARCH HEIGHT	IL	INVERT LEVEL
ASS	ASSUMED CONNECTION	LP	LAMP POST
B	BOLLARD	LS	LIGHT SWITCH
BH	BEAM HEIGHT	MKR	MARKER
BGP	BREAK GLASS POINT	NB	NOTICE BOARD
BOL	BOLLARD	NIB	NOTICE BOARD INFORMATION
BSP	BUS STOP POST	NP	STREET NAME PLATE
BW	BRICK WALL	O/H	OVERHEAD
CAN	CANOPY	PL	PLANTER
CDP	CABLE DUCT	PL	PAVEMENT LIGHT
CE	CLEANING EYE	RAD	RADIATOR
CL	COVER LEVEL	RG	ROAD GULLEY
CLR	CLEAR HEIGHT	RL	RAIL LEVEL
CONC	CONCRETE	RSJ	ROLLED STEEL JOIST
CPG	CONC. PAVING SLABS	RW	RETAINING WALL
CTV	CABLE TELEVISION	SDP	STORM DRAIN PIPE
CTV	CABLE TELEVISION	SC	STOP COCK
D	DOOR HEIGHT	SH	SPRING HEIGHT
DP	DOWN PIPE	SP	SIGN POST
ECP	ELEC. CABLE PIT	SL	SUMP LEVEL
EO	ELECTROPT 'O'	SV	SLUICE VALVE
EP	ELECTRICITY BOX	TBM	TEMPORARY BM
EP	ELECTRICITY POLE	TCB	TELEPHONE CALL BOX
FR	EARTHING ROD	TC	TELECOMMUNICATIONS IC
FH	FIRE HYDRANT	TP	TELEPHONE POLE
FH	FIRE HYDRANT	TS	TELEPHONE STILE
FG	FEEDS INTO GROUND	TS	TRAFFIC SIGNAL
FP	FEEDER PILLAR	TSG1	TRAFFIC SIGNAL GT
FP	FEEDER PILLAR	TSC	TRAFFIC SIGNAL CT
G	GULLEY	UTL	UNABLE TO LIFT
GV	GAS VALVE	VP	VENT PIPE
H	HEIGHT	WH	WINDOW HEAD HEIGHT
HB	HAND BASIN	WM	WATER METER
HD	HEAD DRAIN DUCT	WSH	WINDOW SILL HEIGHT
HYD	HYDRANT	WV	WATER VALVE

FENCE TYPES AND DETAILS

BWF	BARBED WIRE	OBF	OPEN BOARD FENCE
CBF	CLOSED BOARDED	PBF	POST & RAIL
CLF	CHAIN LINK	PWF	POST & WIRE
CPF	CHESTNUT PALING	RF	PANEL
GER	GUARD RAILS	RAIL	RAILINGS
IRF	IRON RAILINGS	(SEC)	SECURITY

LEVEL DATUM

DATUM USED : OS GPS ACTIVE NETWORK

REVISION

No.	DATE	REVISION

CORSTORPHINE + WRIGHT
ONE MORTIMER STREET
LONDON
W1T 3JA

JOB TITLE
5 MONDIAL WAY
BATH ROAD
HEATHROW
MIDDLESEX
UB3 5AR

DRAWING TITLE
SITE SURVEY

SURVEYOR: YI	DRAWN: OH	CHECKED: AW
SCALE 1/100		SHEET No: SHEET 1 OF 1
DATE FEB 2017	SHEET SIZE A0	DRAWING No: 6297_SITE_R0