




SAFESCAPE SERVICES LIMITED

SAFESCAPE SERVICES LIMITED
KINGSTON ROAD, BARNET, MIDDLESEX, ENGLAND, HA5 2JG

Endeavour House
259 Forstal Road
Aylesford Kent ME20 7AQ
Tel: +44 (0) 1622 862 282
Fax: 01622 331066
Mob: 07973 194109
E-Mail: nicholas.holness@btinternet.com

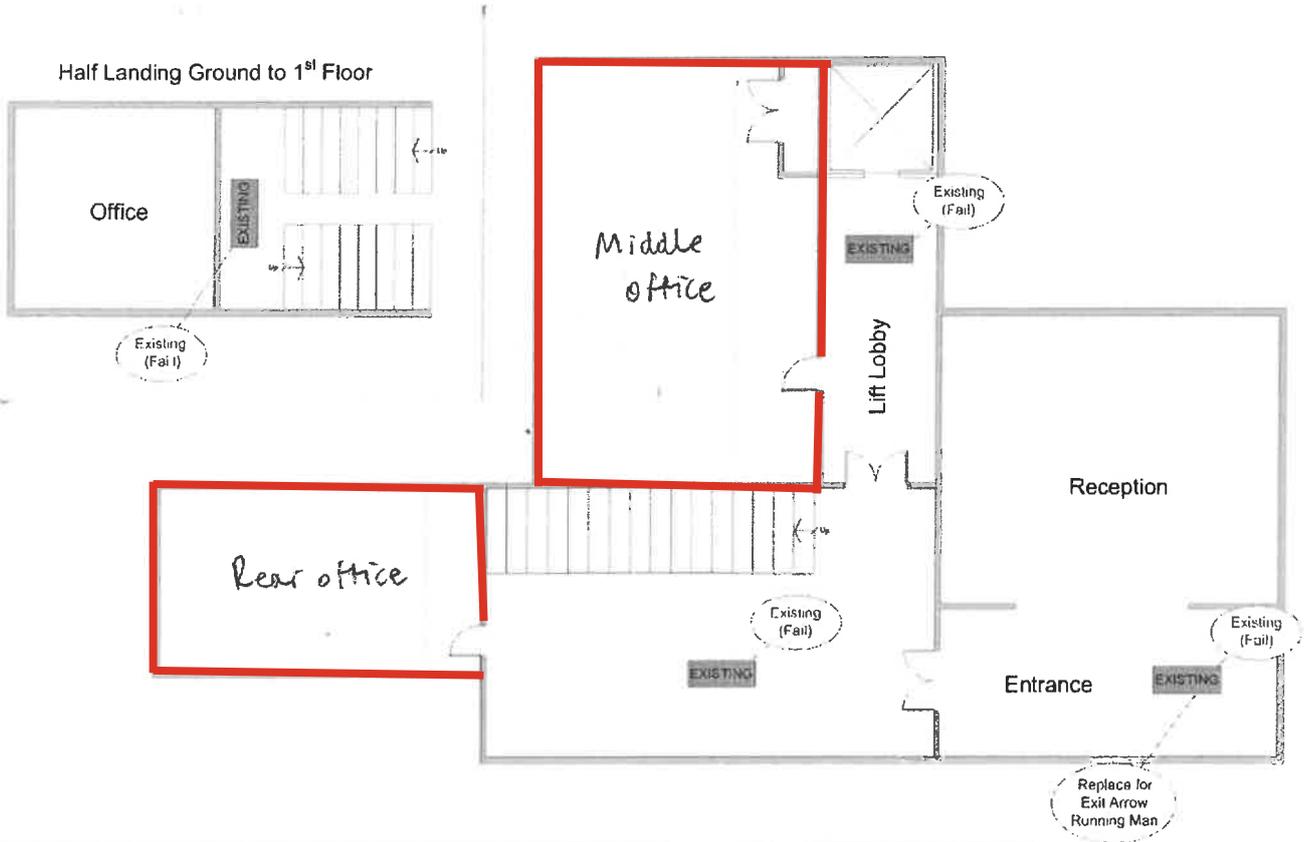

	Project Rismenda, 4 Hill Street, London W1	Title Ground Floor Emergency Lighting Proposal to BS5266	Key Proposed New 8 Watt 3 Hour Emergency Light Firing Existing Emergency Light Firing
	Date 22 nd May 2008	Drawing Number N HSA/GF 00 1	

Basement Office Floor Plan

