


1st Floor

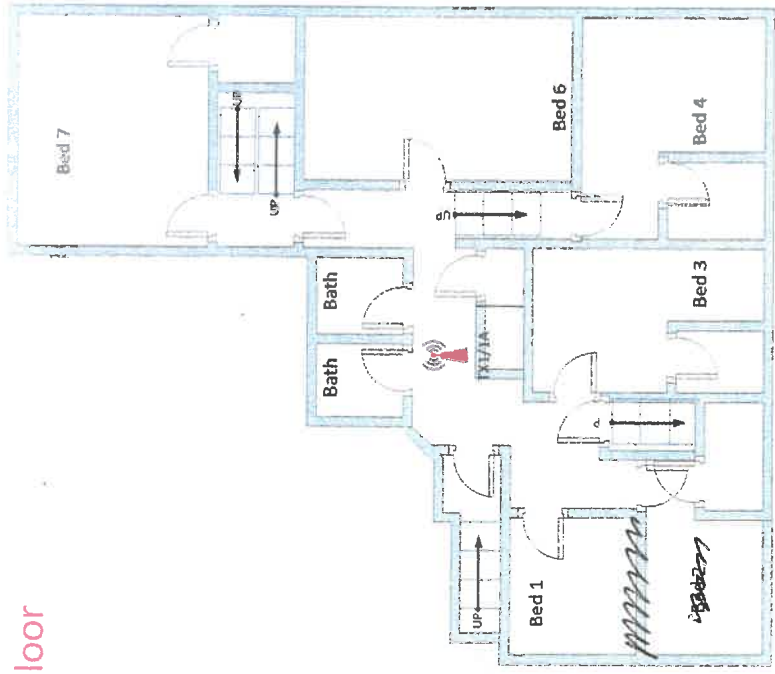

2nd Floor

