





GROUND FLOOR LOBBY (WITH STAIRCASE)

- NOTES:**
1. Internal and External wall thicknesses are not to scale.
  2. Location of Gas, Water and Electrical incoming mains and meters are indicative and not to scale.
  3. All dimensions taken to tenants fit-out.

**LEGEND:**

-  Distribution Box
-  Water
-  Gas
-  Finished floor level to clear ceiling height

REV	DATE	DESCRIPTION	DRN	CHK	APP
Rev	Date	Description	Drm	Ch	App



PROJECT:  
**PROPERTY CONDITION  
SURVEYS**



Registered office:  
Arcadis Consulting (UK) Limited  
80 Fenchurch Street  
London EC3M 4BY  
United Kingdom  
Tel +44 (0)20 7812 2000  
[www.arcadis.com](http://www.arcadis.com)

TITLE:


**U142180**  
**Unit 7 Parsons Green Depot,**  
**SW6 4HS**

Measured	TC	Date	20-Dec-23
Drawn	NF	Date	22-Dec-23
Checked	CD	Date	22-Dec-23
Approved	TC	Date	22-Dec-23
Scale:	1:50		
Original Size:	A3		
GIFA (m²):	11.97	Project Num	10028245

TfL Document Name:  
**PAG-U142180-GENR-DWG-2312**


Unit Reference: U142180  
Unit Description: Unit 7 Parsons Green Depot  
Station Group : Parsons Green


Drawing Number:	Revision:
001	0

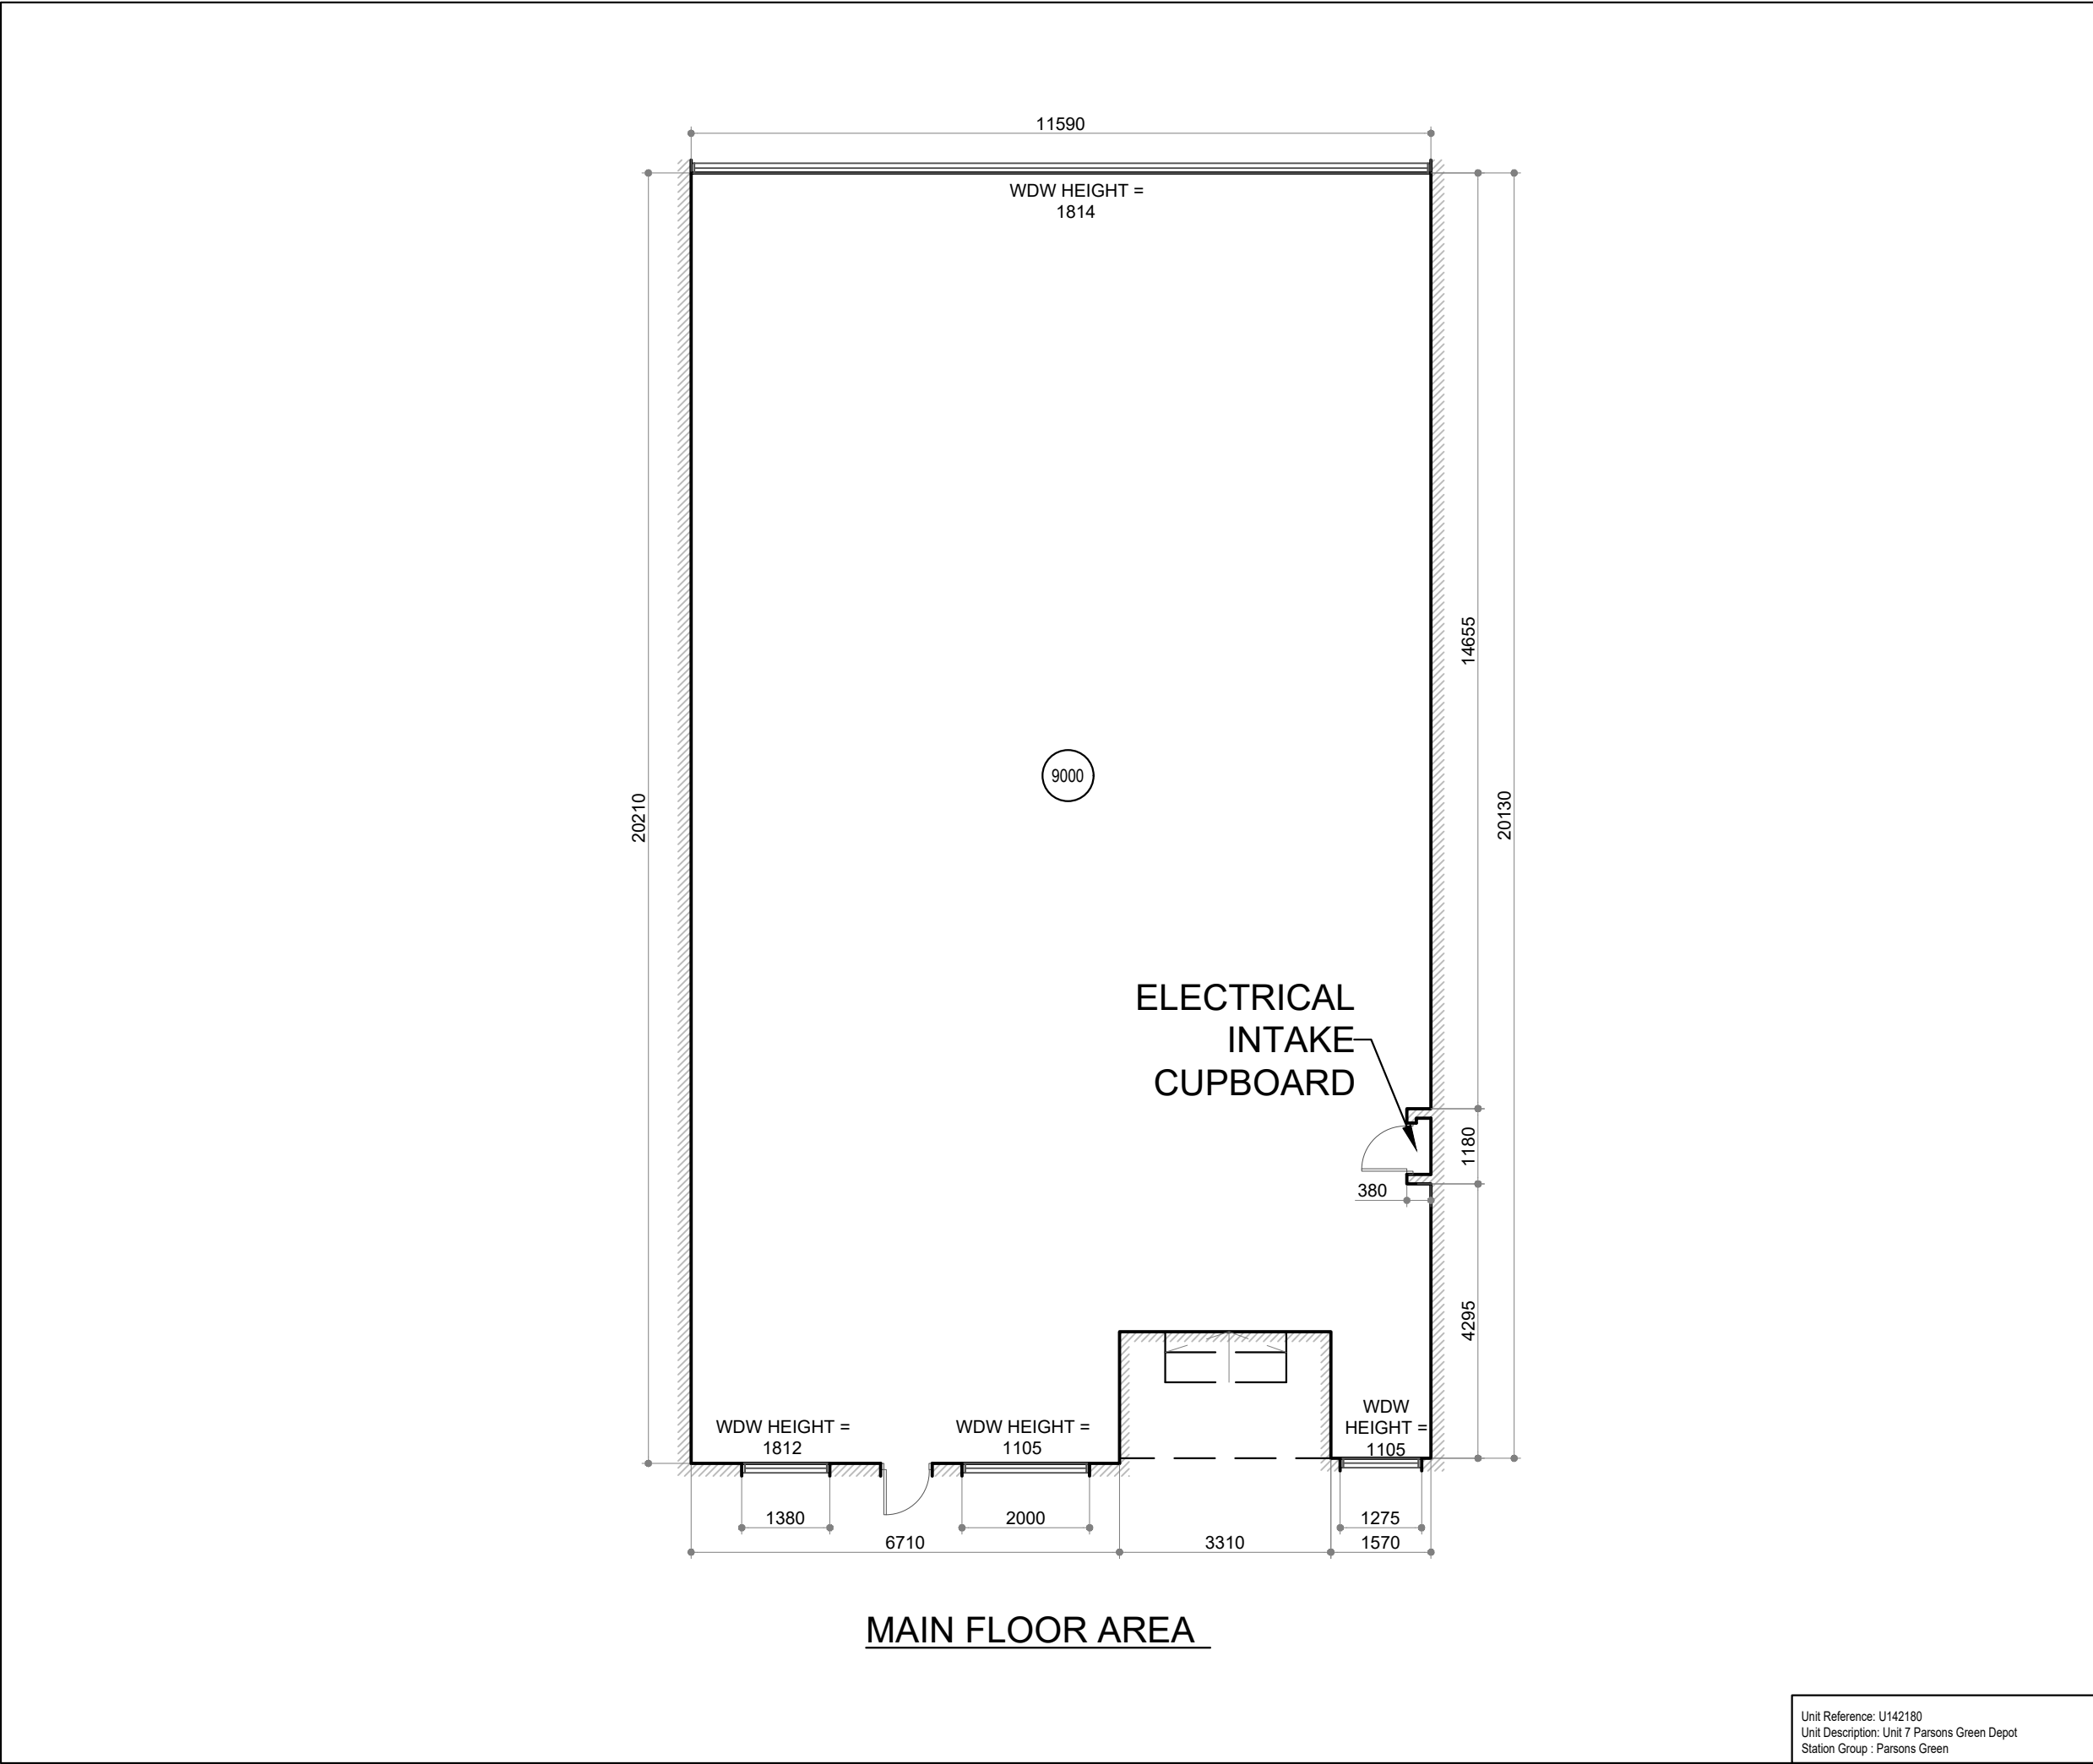



- NOTES:
1. Internal and External wall thicknesses are not to scale.
  2. Location of Gas, Water and Electrical incoming mains and meters are indicative and not to scale.
  3. All dimensions taken to tenants fit-out.

LEGEND:

 Distribution Box

 Water

 Gas

 Finished floor level to clear ceiling height

REV	DATE	DESCRIPTION	DRN	CHK	APP
Rev	Date	Description	Drm	Ch	App



PROJECT:  
PROPERTY CONDITION  
SURVEYS



Registered office:  
Arcadis Consulting (UK) Limited  
80 Fenchurch Street  
London EC3M 4BY  
United Kingdom  
Tel +44 (0)20 7812 2000

www.arcadis.com

TITLE:

U142180  
Unit 7 Parsons Green Depot,  
SW6 4HS

Measured	TC	Date	20-Dec-23
Drawn	NF	Date	22-Dec-23
Checked	CD	Date	22-Dec-23
Approved	TC	Date	22-Dec-23
Scale:	1:100		
Original Size:	A3		
GIFA (m²):	227.15	Project Num	10028245

TfL Document Name:  
PAG-U142180-GENR-DWG-2312

Unit Reference: U142180  
Unit Description: Unit 7 Parsons Green Depot  
Station Group : Parsons Green

Drawing Number:	002	Revision:	0
-----------------	-----	-----------	---