
© COPYRIGHT RESERVED
Do Not Scale From Paper Copies

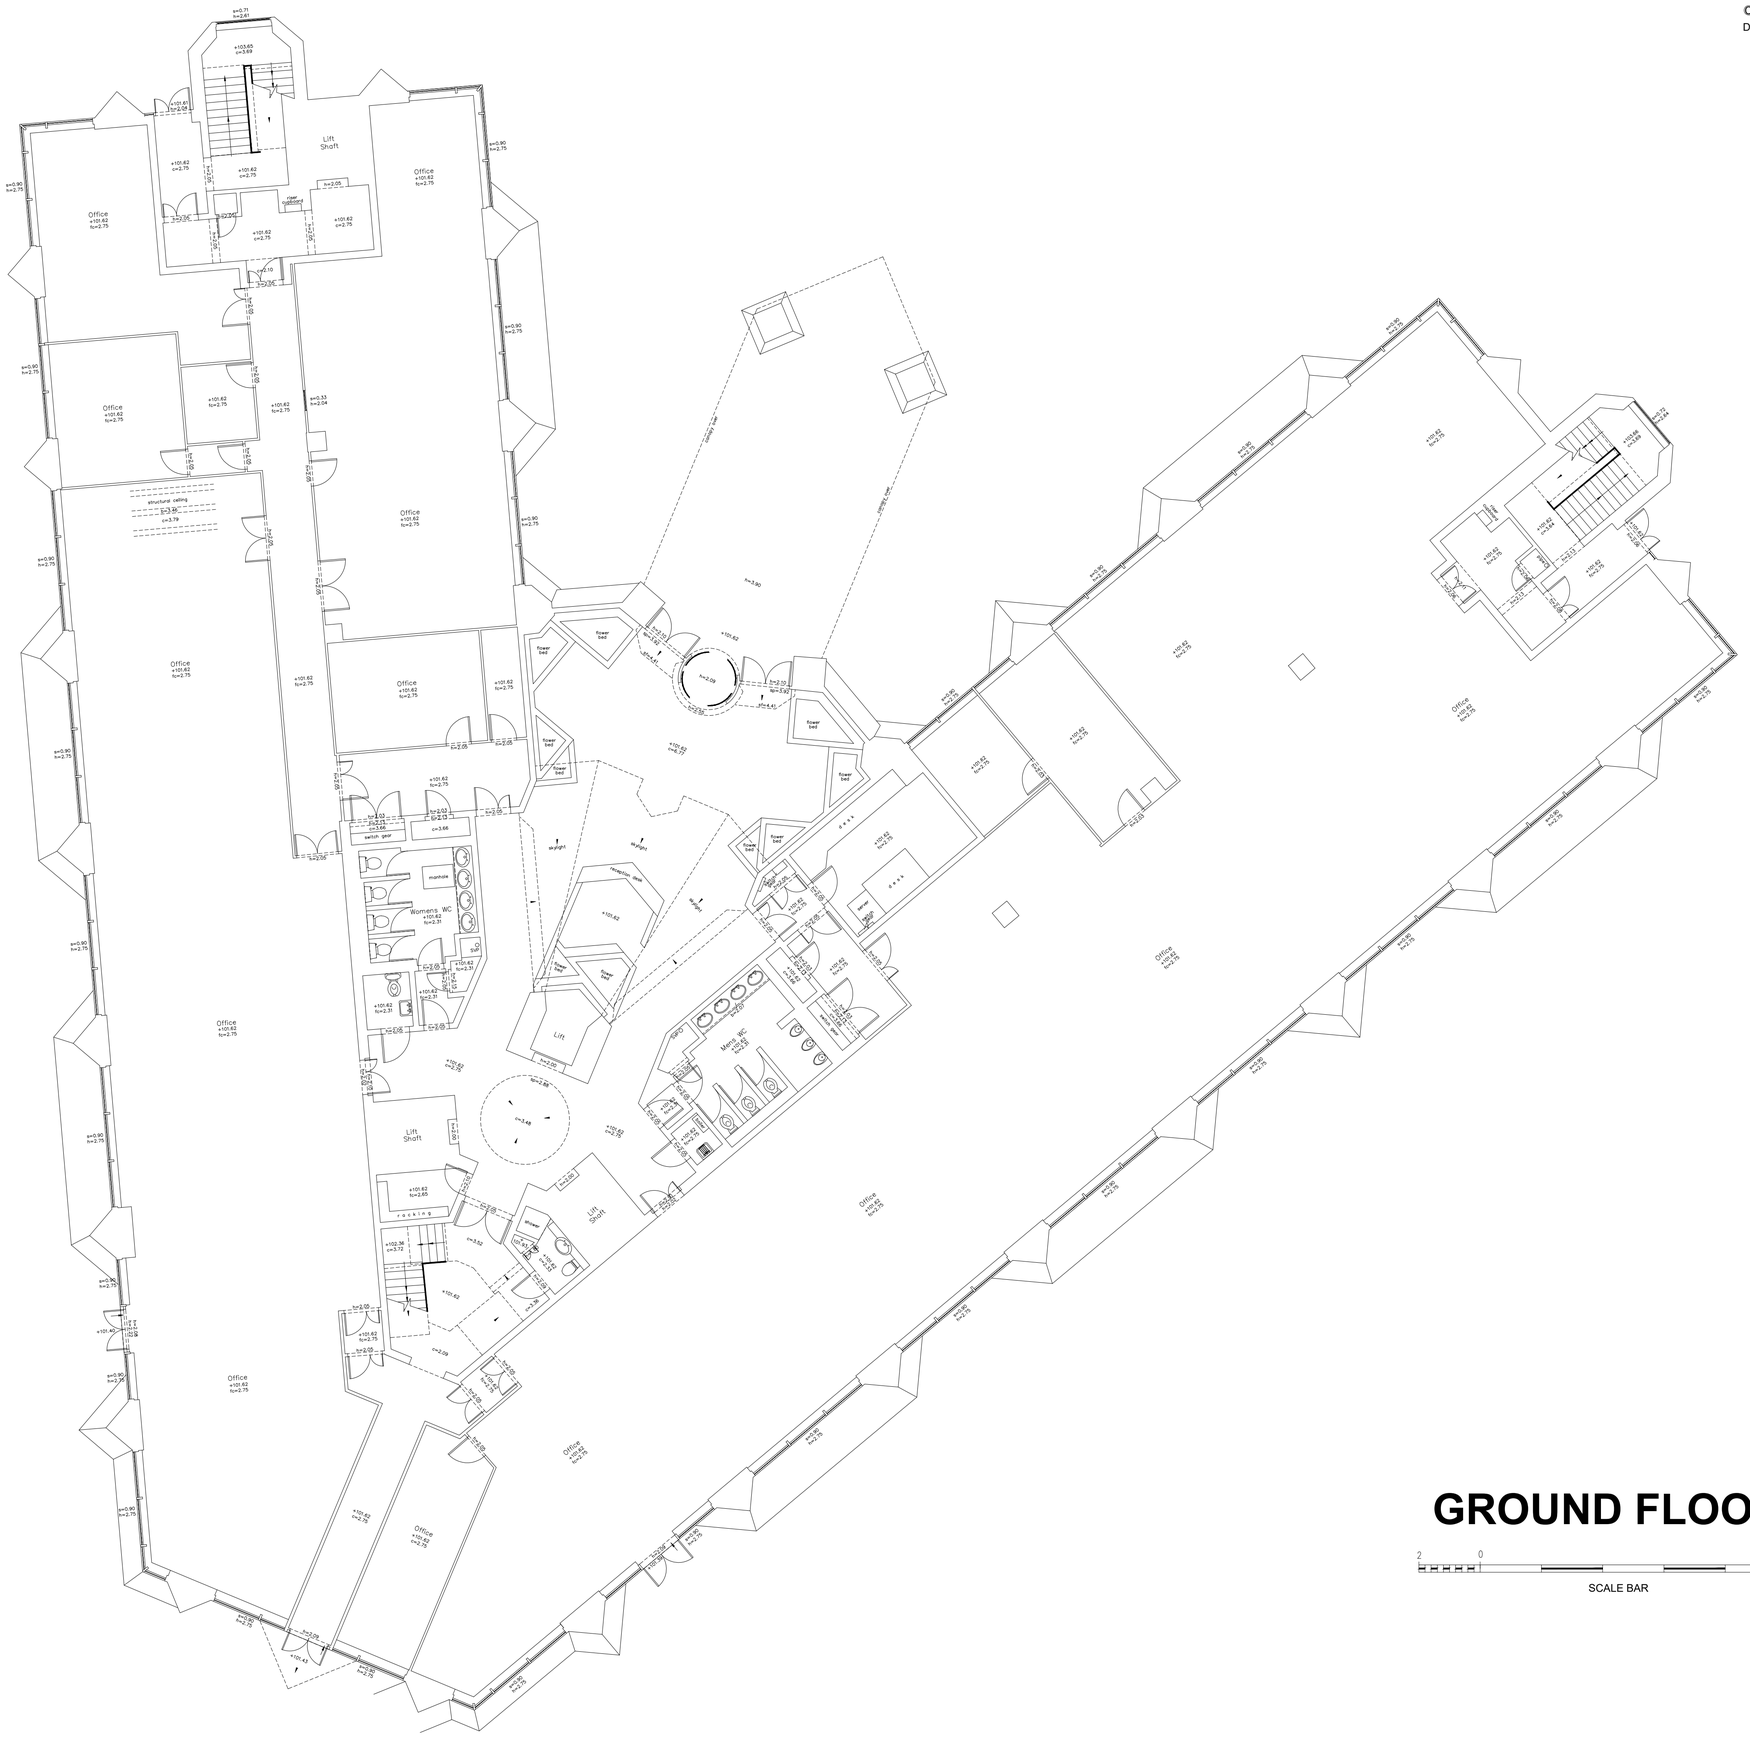

All levels related to Ordnance Survey active GPS network, at survey station S3.

KEY

A — Section Line — A`

- Box partition
- Step/Ramp up
- Stair cut line
- Overhead Feature
- Fit Mark
- Radiator
- Slope up
- A — Elevation Location
- Approximate/ Assumed Position

ABBREVIATIONS

p = Plinth Height
s = Sill Height
h = Head Height
c = Ceiling Height
b = Beam Height
sp = Spring Point Height
fc = False Ceiling Height
sc = Structural Ceiling Height
sf = Soffit Height

RL = Ridge Level
EL = Eaves Level
RFL = Roof Level
SFL = Soffit Level
THL = Threshold Level
FFL = Finished Floor Level
PWL = Parapet Wall Level
+35.20 = Levels
52.76 = Elevation level

AB = Air Brick
AHU = Air Handling Unit
AV = Air Vent
CB = Cupboard

JB = Junction Box
RSJ = Rolled Steel Joist
WT = Worktop

Client
PEGASUS PLANNING GROUP (LONDON)

Project
ELSTREE TOWER, ELSTREE WAY, BOREHAMWOOD, WD6 1SD

Title
FLOOR PLAN

Drawing Number
TS22-292-ET-1

Revision	Description	Rev. By	Date

Scale	Sheet	
1:100@A1	1	of 8

Drawn by	Checked by	Date of Survey
AB	PG	JULY 2022

TERRAIN SURVEYS
Tel: 01438 841300
www.terrainsurveys.co.uk
enquiries@terrainsurveys.co.uk

Accreditations:
chartered ices
THE SURVEY ASSOCIATION
ISOQAR 0026 Certificate Number 1798 ISO 9001
Constructionline Gold Member
CHAS Accredited Contractor CHAS.co.uk