


Floor Plan Legend:	
	Window Cill & Head Height
	Overhead Detail
	Door Height From FFL
	Stairs/Step
	Radiator
	Ventilation / Overhead
	Access Hatch

	TV Point
	Phone Point
	13A Power Socket
	Fused Socket
	Shower Socket
	Extractor Fan
	Lantern Light
	Down Light
	Light Dimmer Switch
	Light Switch
	Fixed Lighting
	Fire Alarm Button
	Fire Extinguisher
	Room Name
	Floor Covering
	Ceiling Height
	Internal Floor Level

Topographic Legend:	
	Buildings / Walls
	Building Canopy / Overhang
	Concrete edge
	Kerb line
	Centre Line
	Barrier
	Hedge
	Security Fence
	Panel Fence
	Gate
	Overhead Line
	Tree / Sapling
	Tree Canopy Line
	Chambers
	Survey Station & Name

	Bench Mark
	Temporary Bench Mark
	Cover level
	Invert level
	Pipe invert (diameter)
	Gully
	Manhole
	Inspection chamber
	Flag Staff
	Gas Marker
	Electric Post
	Trench Post
	Pipe Invert
	Gully
	Building Post
	SI Cover
	Cover Unbroken
	Traffic Light
	Fire Hydrant
	Gas Cover
	Slip Valve
	Gas Valve
	Peg

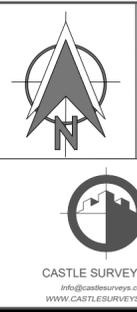

CASTLE SURVEYS LTD
 info@castlesurveys.co.uk
 WWW.CASTLESURVEYS.CO.UK

MIDLANDS **MANCHESTER** **LONDON** **CHELTENHAM** **EDINGBURGH**
 UNIT 12, WINDRIVE OFFICE PARK, LEICESTERSHIRE 97 PRINCES STREET, MANCHESTER 24 POLYARD STREET, LONDON 20 CANNON PLACE, CHELSEA, LONDON 440000 HOUSE, EDINBURGH
 LE03 2AB 0153 638338 011 497 0111 011 498 0200 011 791 620 200 2004 020 749 1111 0131 528 8781

SITE DETAILS:
 11 Plough and Harrow Road,
 Birmingham, B16 8US

TITLE:
 Existing Floor Plans - RP

DRAWING NO.:
 25849-25-02

SCALE: 1: 100	DATE: 25/11/2025
DRAWN: CG	CHECKED: ME
LEVEL DATUM: OSGB36(15)	Paper Size: A2
<small>Comments:</small> This plan should only be used for its original purpose. Castle Surveys Ltd does not accept any responsibility for this plan if supplied to any other party, other than the original client. All dimensions and levels should be checked on site prior to design and construction. Drainage information (where applicable) has been visually inspected from the surface and therefore should be treated as approximate only. Some services may have been omitted due to parked vehicles or due to the site being overgrown with vegetation. Tree information (where applicable) has been surveyed from ground level and therefore should be treated as approximate only. Advise that a tree survey should be carried out. Roof line work (where applicable) is indicative only.	
DO NOT SCALE	
<small>©Copyright Castle Surveys Ltd 2025</small>	