


Notes


This plot has been prepared with a scaling accuracy for a plot at a scale of 1/50

All levels are in metres and related to a local datum.

- ah arch height
- sp springer height
- sh sill to head height
- fs floor to sill height
- u/s underside height
- t/s topside height
- fb floorboard direction
- conc concrete
- rl roof light
- cup'd cupboard
- fp fireplace
- sd sliding door
- s/vp soil and vent pipe
- r/w/p rain water pipe
- carpet carpet
- ⊙ room height
- ↘ roof slope
- ▬ radiator

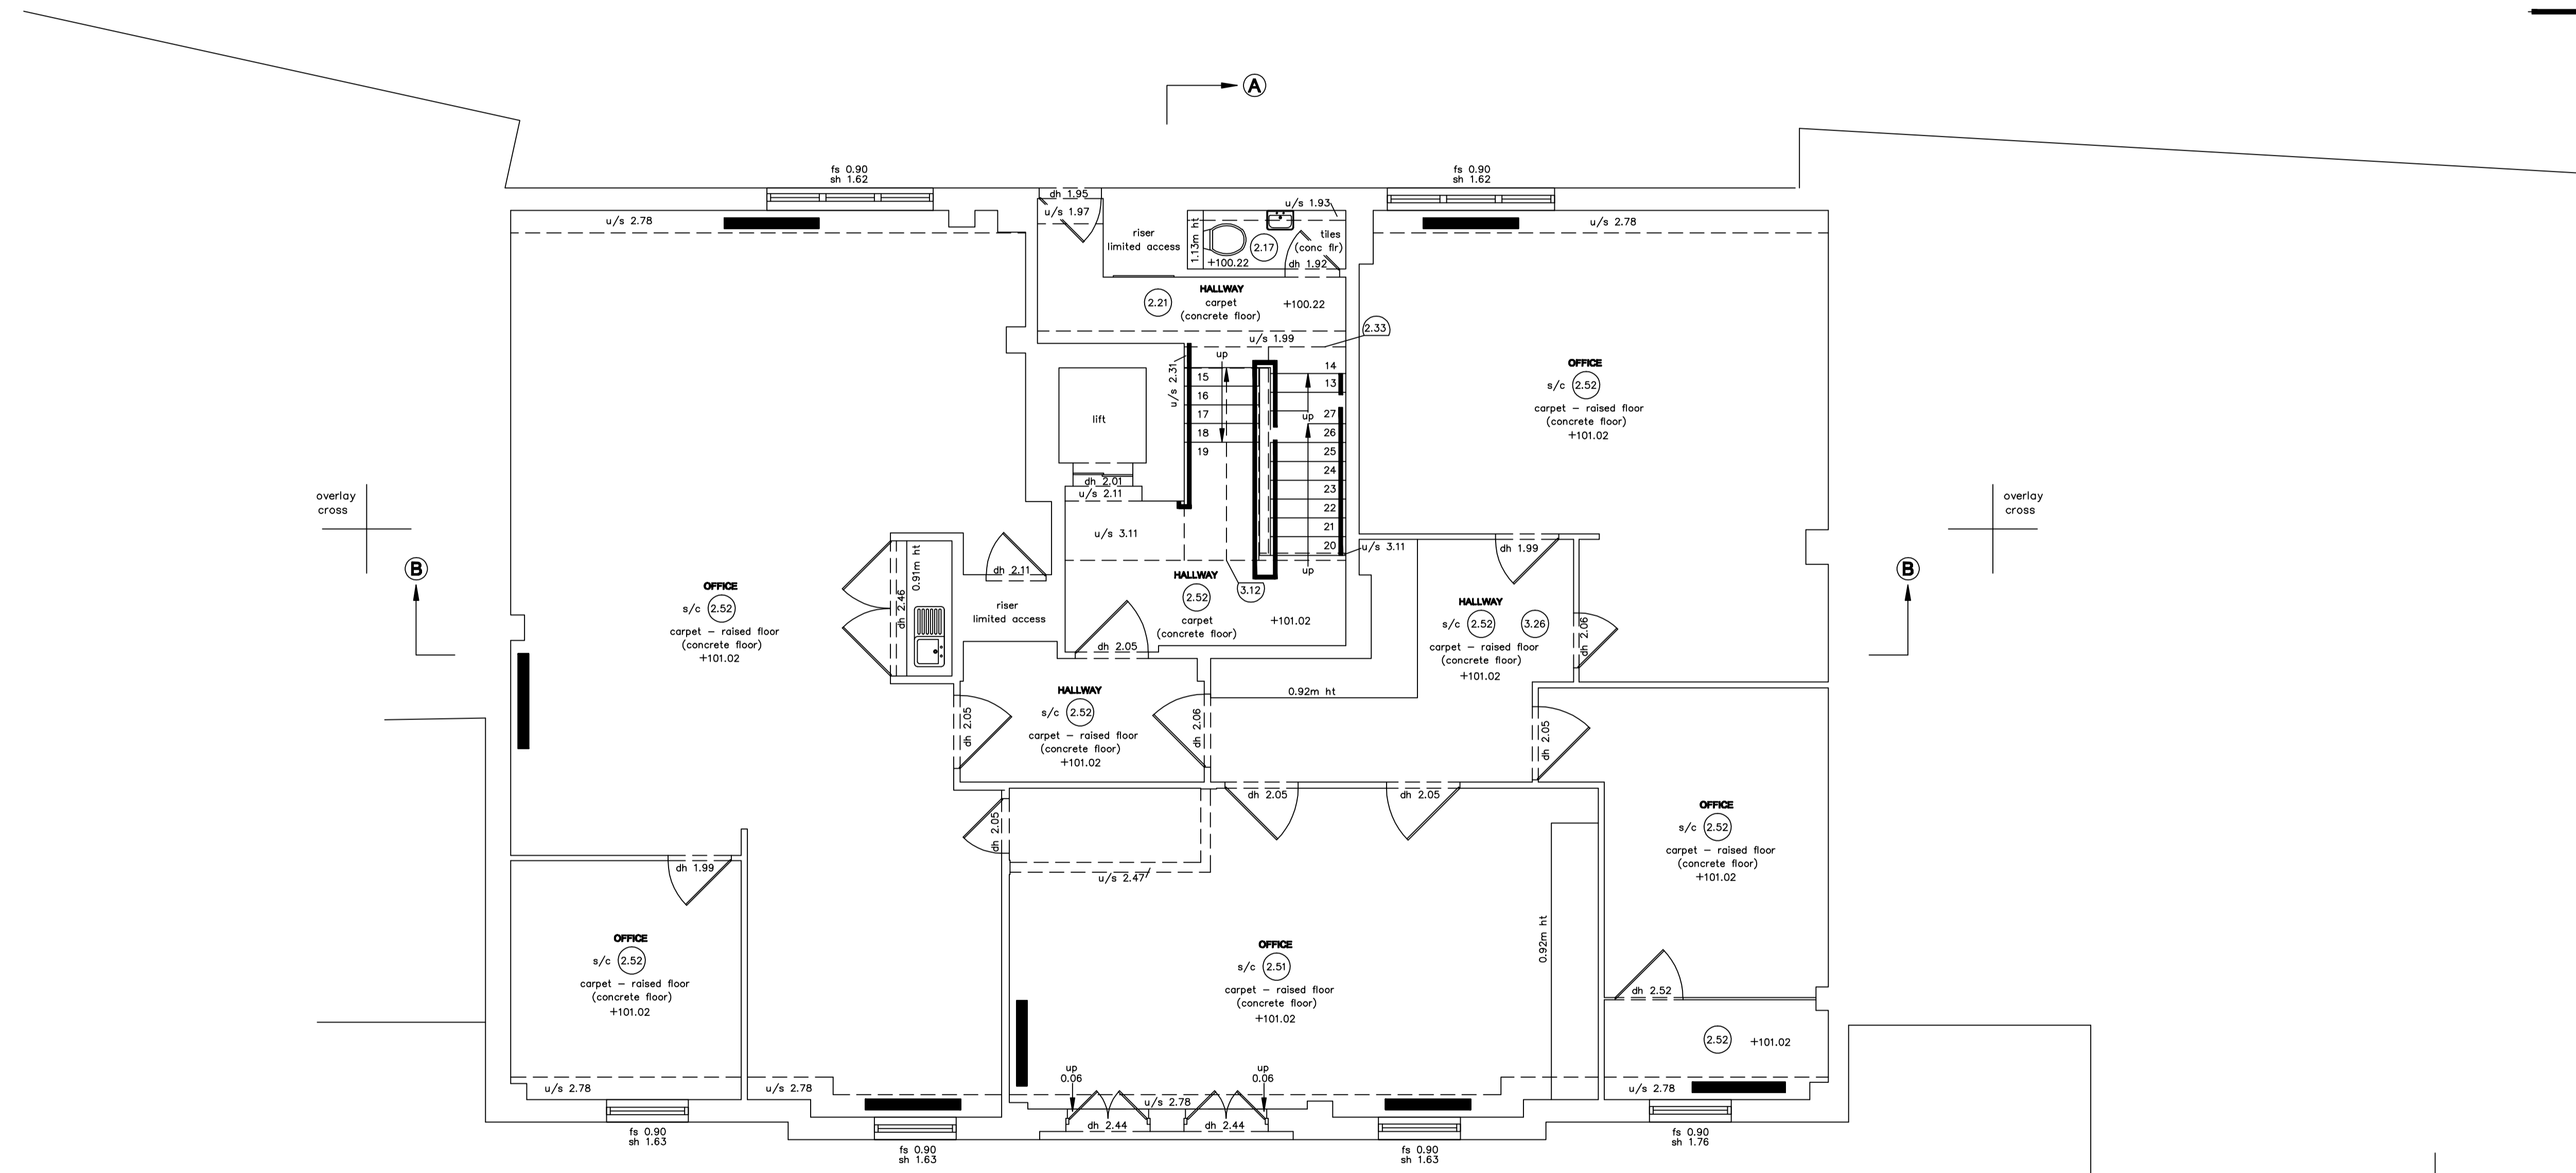

FIRST FLOOR PLAN

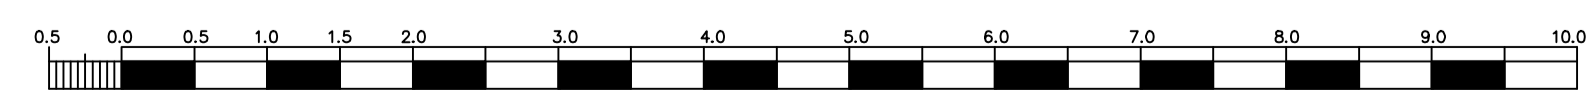

Scale = 1 : 50

CBH/PBH/FFM © CPB Surveys Ltd. A/CAD

JOB
3 Bath Place
Rivington Street
London
EC2 3DR

CLIENT
Ian Hay Architects Limited

TITLE Floor Plan	DWG No 2981/02
----------------------------	--------------------------

SCALE 1/50 @ A1	DATE December 2014
---------------------------	------------------------------

CPB SURVEYS
TOPOGRAPHICAL
AND
MEASURED BUILDING SURVEYORS

PO Box 4256, Leamington Spa, CV31 9BZ
TEL: 01928 429665 FAX: 01928 429665
E-MAIL: info@cpbsurveys.com

