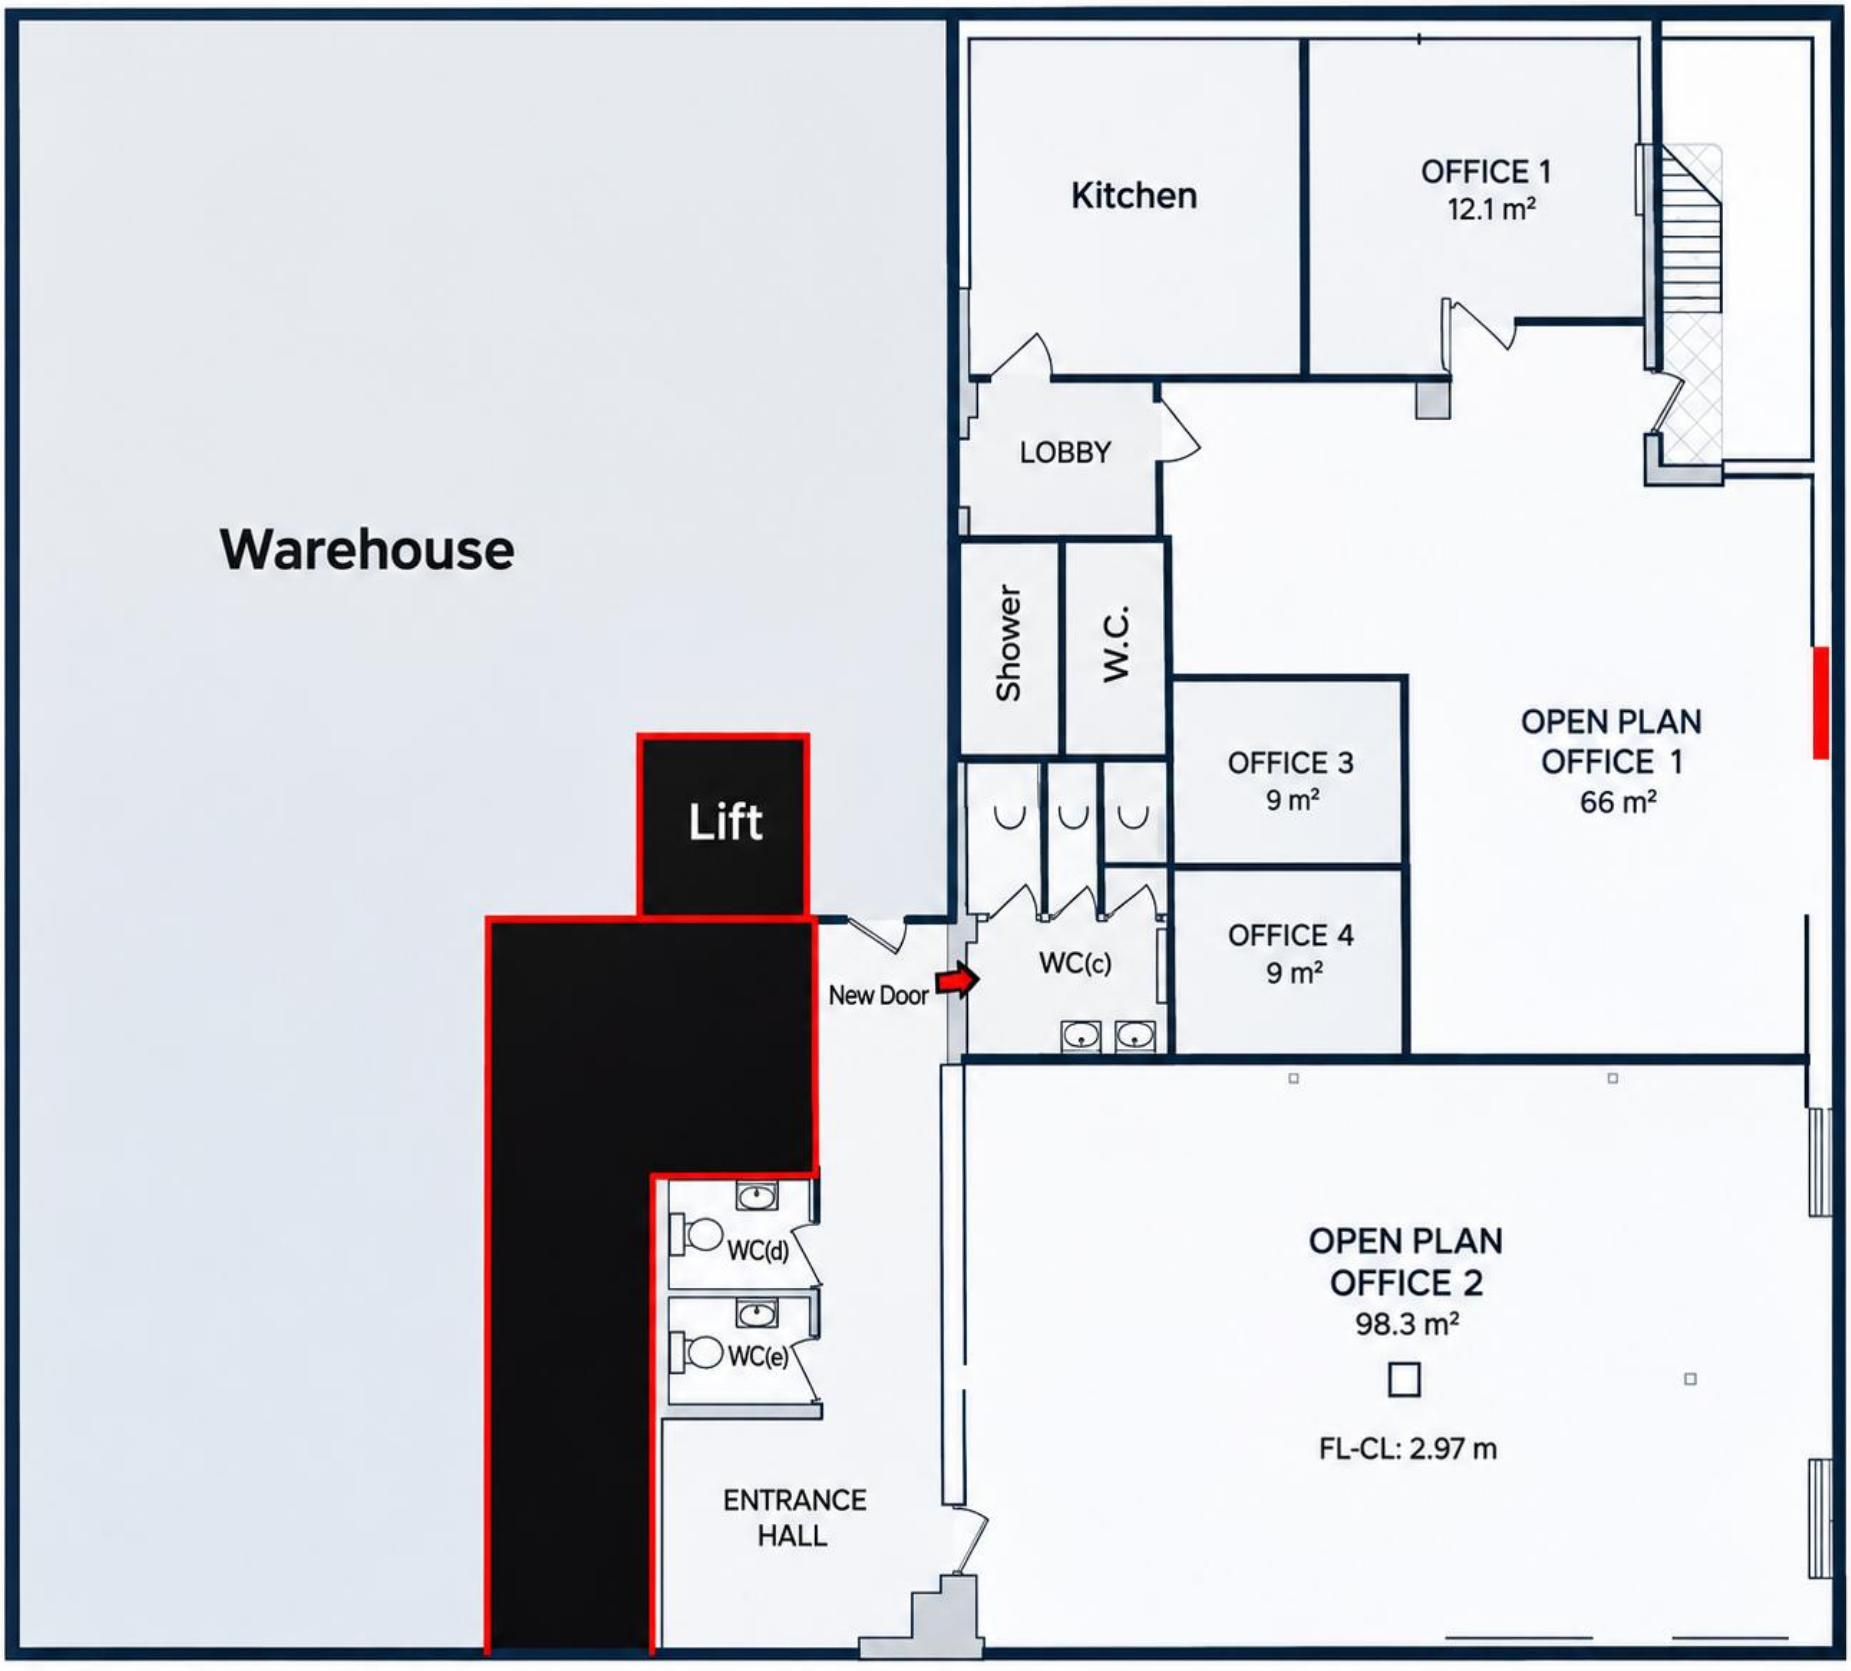


PROPOSED GROUND FLOOR PLAN