



DRAWING TO BE READ IN CONJUNCTION WITH SCOPE OF WORKS

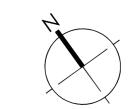

FLOOR PLATE AREA: 6,673 SQFT

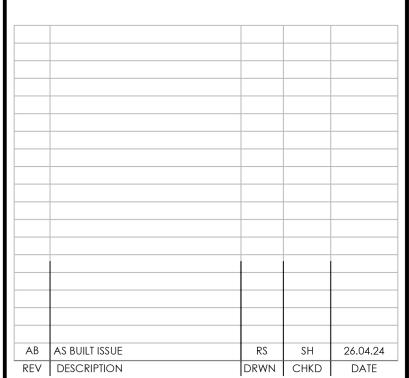

DRAWING STATUS

CLIENT

MACQUARIE GROUP

PROJECT ADDRESS LEVEL 7 8 OLD JEWRY LONDON EC2R 8DN

GENERAL ARRANGEMENT PLAN

SCALE	1:50@A1	DATE	06.11.2
DRAWN	AR	CHECKED	

PROJECT NO BLDG. FLOOR DETAIL REV. | xx-xxxx - 01 - 07 - GA - REV_AB

AIS

Ground Floor, St Paul's London, EC4M 7BP

House, 10 Warwick Lane, enquiries@aisworkplace.com www.ais-interiors.com The copyright in this drawing is vested in Advanced Interior Solutions Group Companies Limited and its subsidiary companies ("AIS"), and no license or assignment of any kind has been, or is, granted to any third party whether by provision of copies, originals or otherwise, unless agreed expressly in writing by AIS. This drawing may not be copied, shown or given to a third party unless agreed expressly in writing by AIS.

© Copyright AIS

Layouts and all dimensions are subject to confirmation on site prior to commencement of any works. Do not scale from this drawing. AIS cannot accept responsibility for the accuracy of scaled plans supplied to us by third parties in either hard copy or PDF formats.